


T. I. N. R. 3 E. W. M.

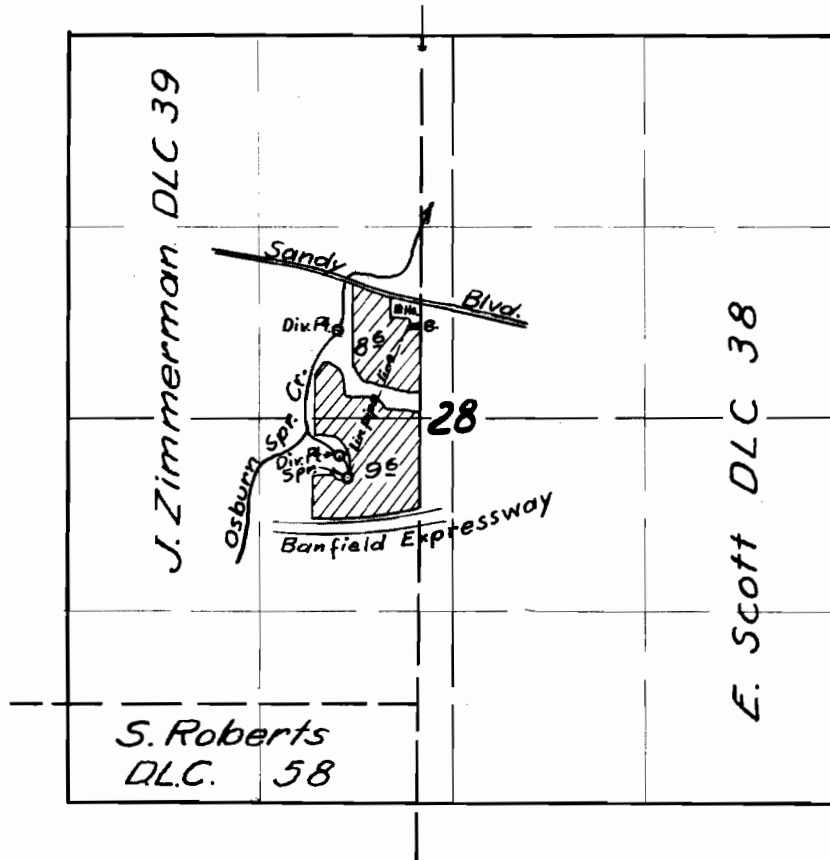

FINAL PROOF SURVEY

UNDER

Application No. 18290... Permit No. 13937...

IN NAME OF

Clay C. Miller

Surveyed 25 July 1950, by Tm. Bish...