


T. 8S. R. 46E. W.M.

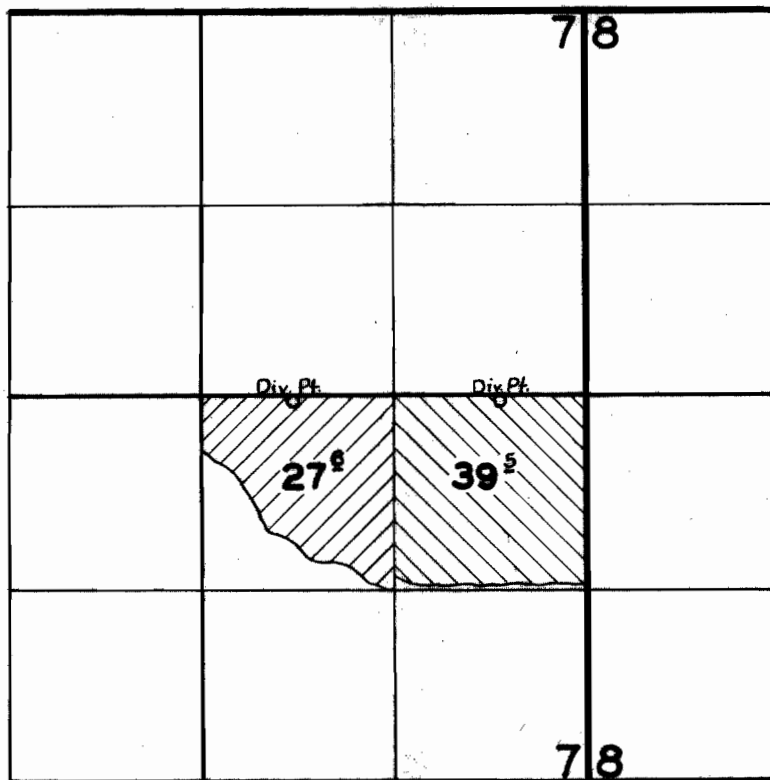

FINAL PROOF SURVEY

UNDER

Application No. 21016 Permit No. 16441
IN NAME OF

L.E. Boyer, Ernest McQueen, Robert W. Thomas

Surveyed 12 OCT. 1956, by M. BISH

BBB-9N-113

205