


T. 2 S. R. 5 E. W. M.

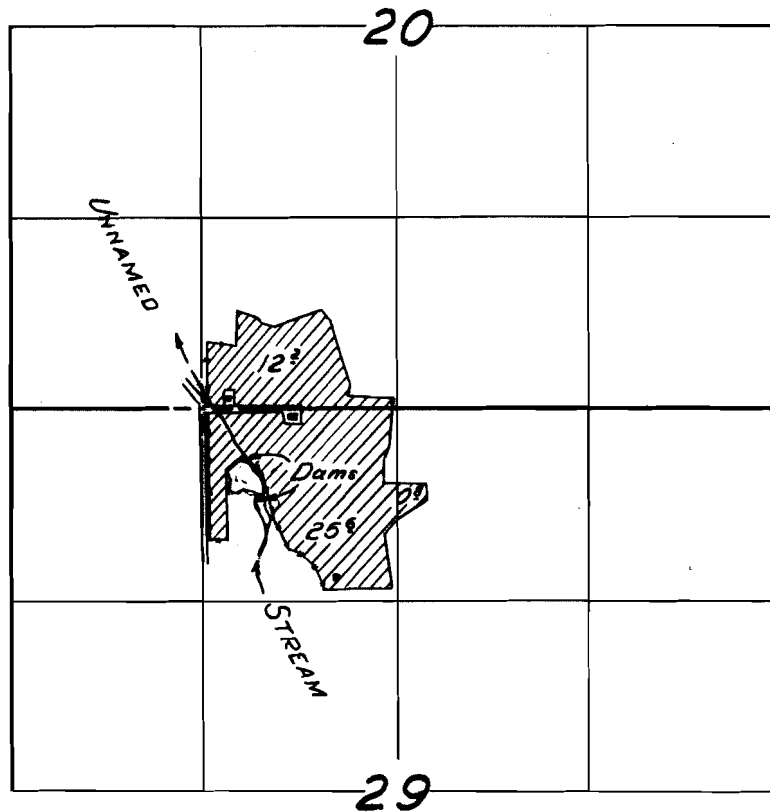

FINAL PROOF SURVEY
UNDER

Application No. 23885 Permit No. 18672

IN NAME OF

MELVIN M. WERNER

Surveyed 15 June 1956, by Chubb