


T.38 & 4 N.R.108 & 11 W.W.M.

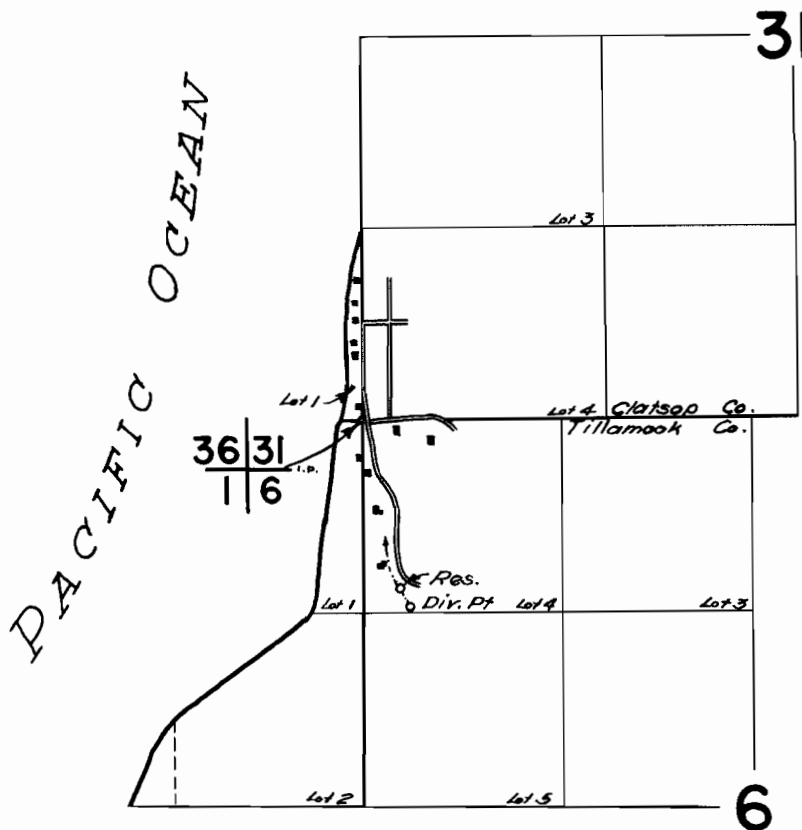

FINAL PROOF SURVEY UNDER

Application No. 24276... Permit No. 19118.....
IN NAME OF

Falcon-Cove Beach Domestic Water Supply District

Surveyed July 23 1963, by *L. Jackson*