


RECEIVED

MAY 7 1951
STATE ENGINEER
SALEM, OREGON

ARTHUR ERIKSON MOHLER, ORE.

WATER RIGHT FOR IRRIGATION
 $S\frac{1}{2}$ SW $\frac{1}{4}$ SEC. 7, N $\frac{1}{2}$ NW $\frac{1}{4}$, SW $\frac{1}{4}$
NW $\frac{1}{4}$, SEC. 18, T2N R9W
SCALE 1" = 500'

AREA TO BE IRRIGATED

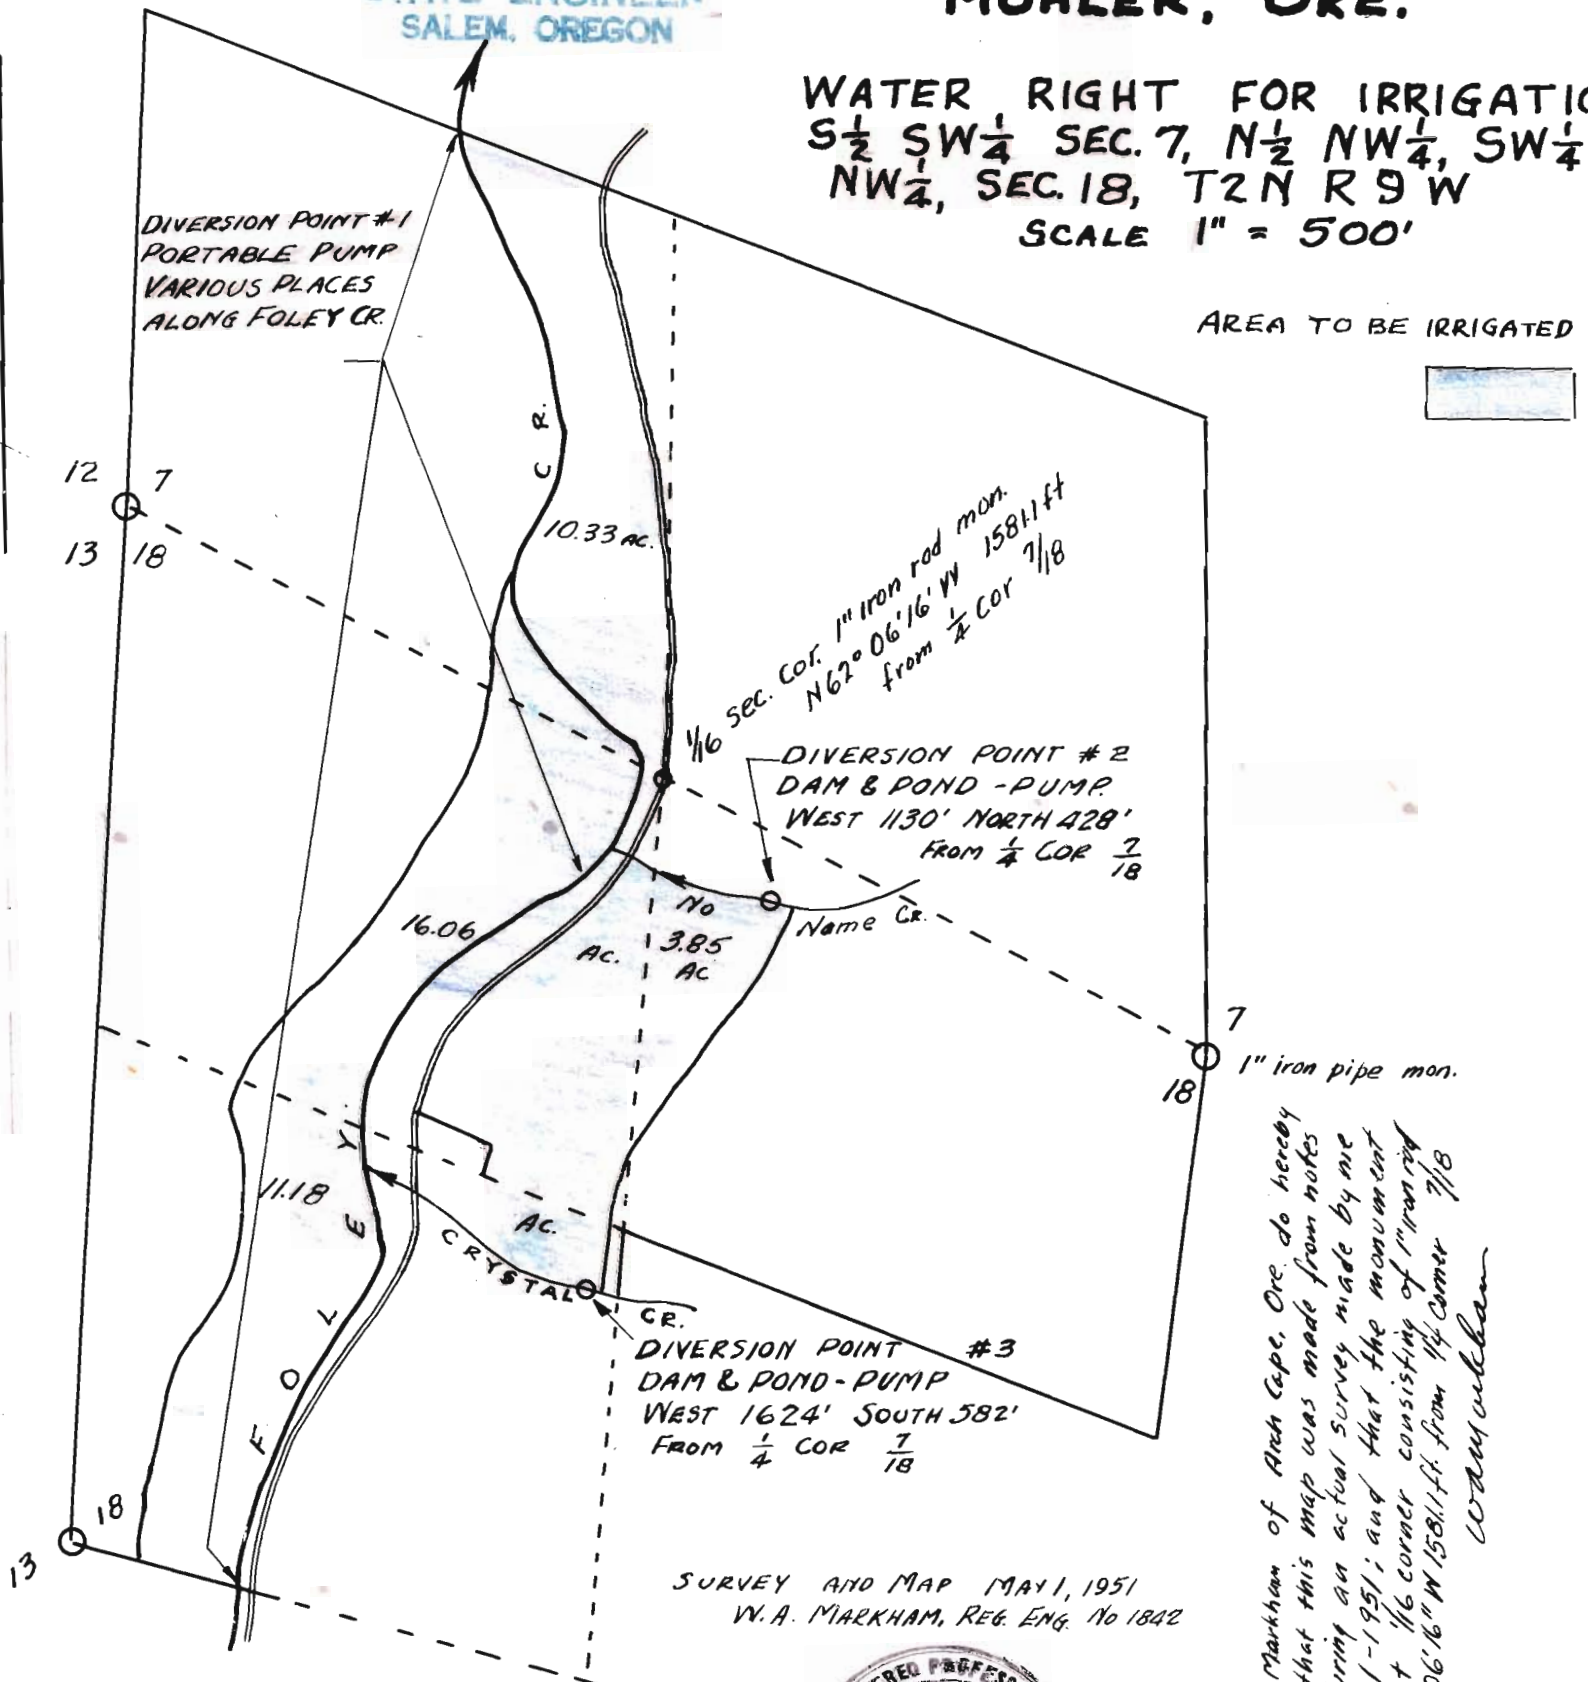

Application No. 25908
Permit No. 20540



I, W.A. Markham of Arch Cape, Ore. do hereby
Certify that this map was made from notes
taken during an actual survey made by me
on May 1-1951; and that the monument
shown at $\frac{1}{16}$ corner consisting of 1" iron rod
is N62° 06' 16" W 1581.1 ft. from $\frac{1}{4}$ corner $\frac{7}{18}$
W.A. Markham