


T.2N. R.3W. W.M.

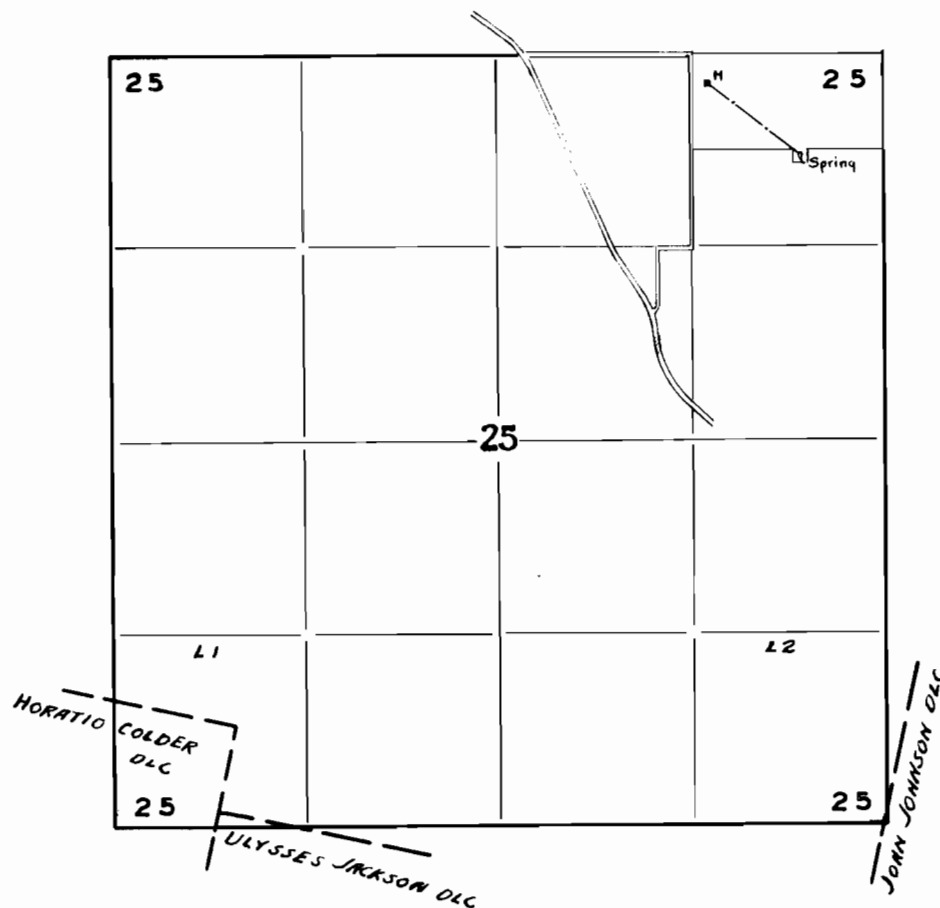

FINAL PROOF SURVEY

UNDER

Application No. 28028 Permit No. 22052

IN NAME OF

GEORGE GAMEL

Surveyed 4 - 9 1956, by R.H. WHITBY