


T-6823

T. 1 S., R. 2 W., W. M.

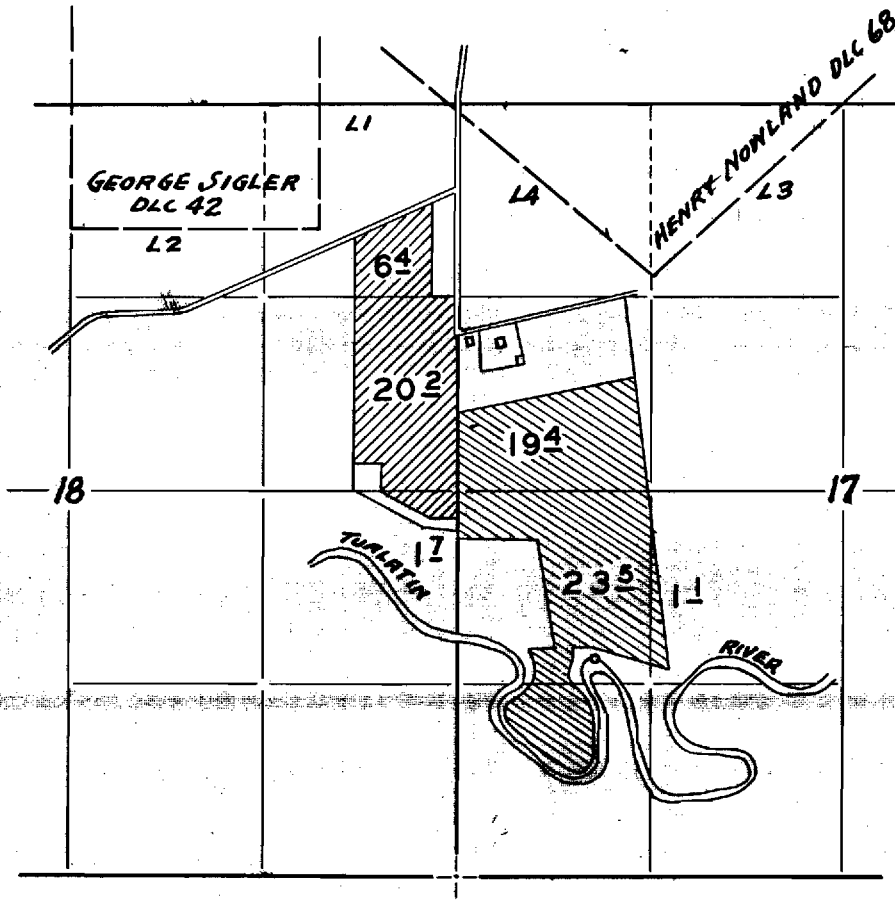

FINAL PROOF SURVEY


UNDER

28030

22054

Application No. 24388

Permit No. 19240

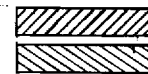

IN NAME OF

LAWRENCE L. WAIBEL

Surveyed 4 - 19 1956, by M. BISH