


T. 2 S., R. 2 W., W.M.

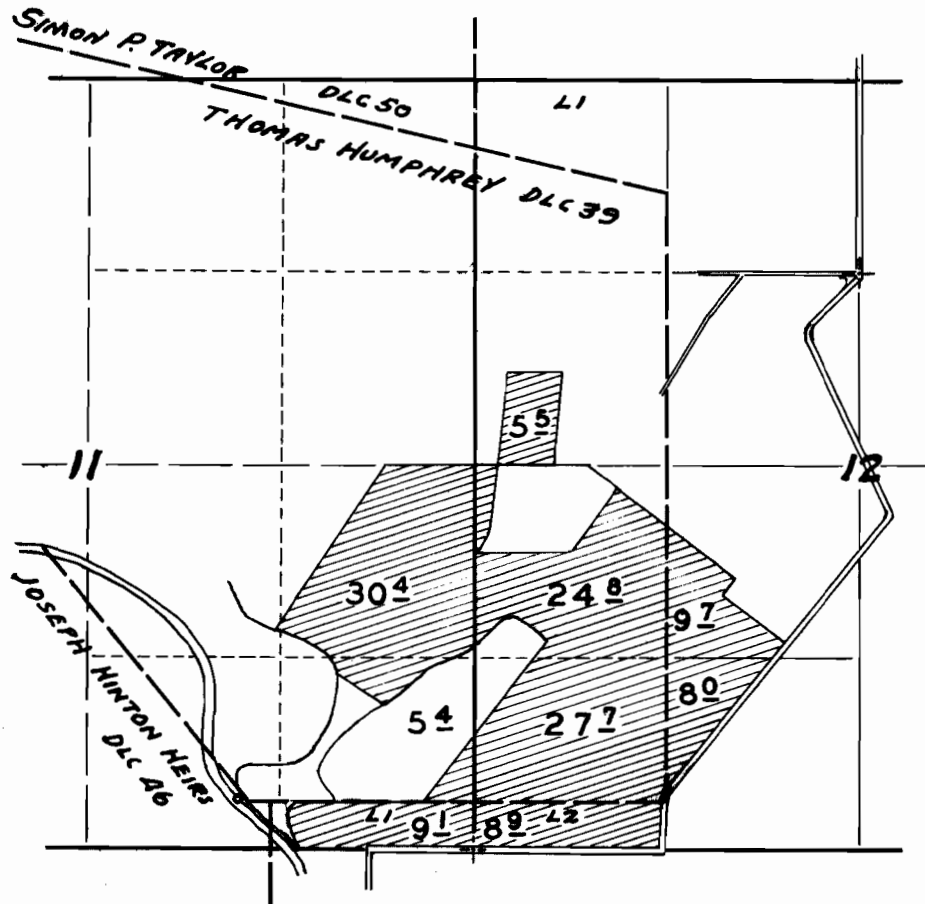

**FINAL PROOF SURVEY**

UNDER

Application No. 28453 Permit No. 22287  
IN NAME OF

OLESON BROTHERS

Surveyed 5 - 7, 1956, by M. BISH