


T. 5 S. R. 6 W. W.M.

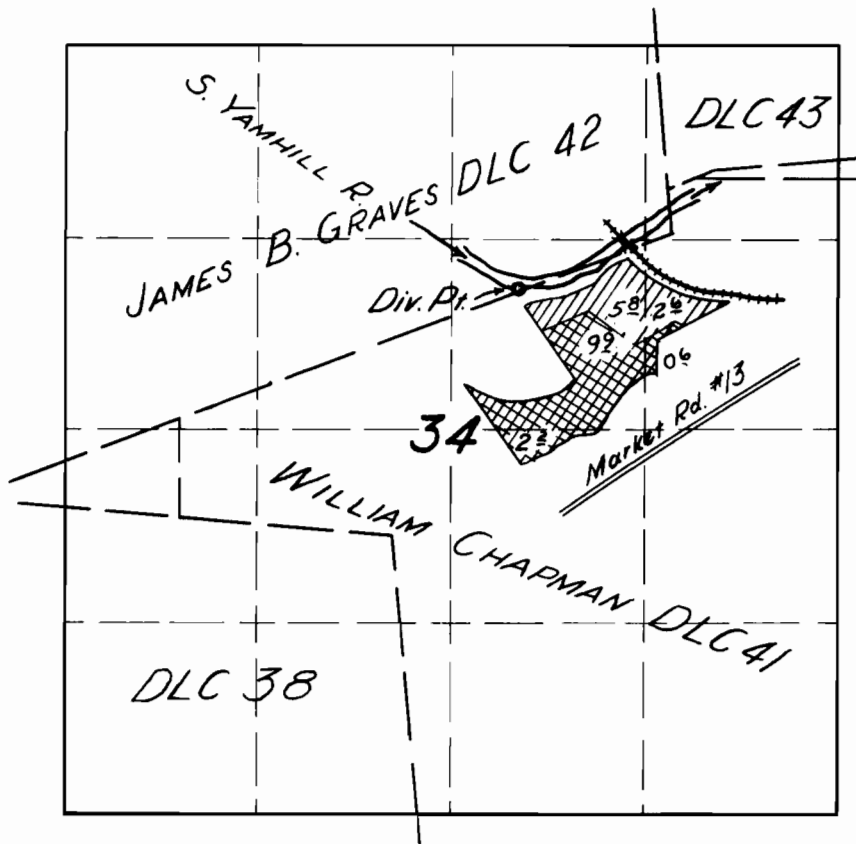

FINAL PROOF SURVEY

UNDER

Application No. 28525 Permit No. 22325

IN NAME OF

G. D. WOLFER

Surveyed 13 Mar 1956, by C. R. White