


T.2S. R.6E. WM

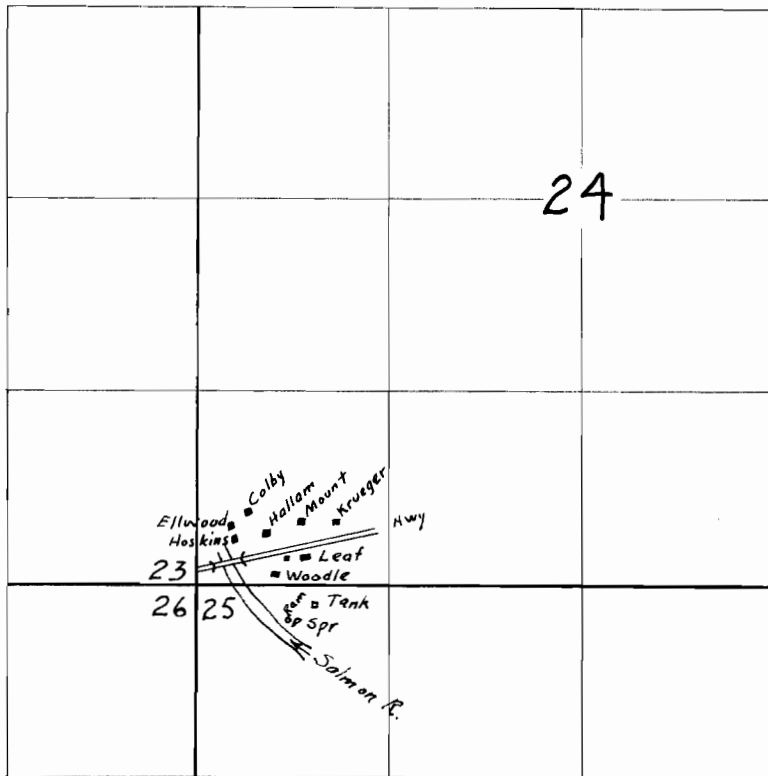

**FINAL PROOF SURVEY**  
UNDER

Application No. 28373 Permit No. 22386  
IN NAME OF

R.B. Community Water System Inc.

Surveyed Aug 23 1957, by C.O. Bartels