


T.2S. R.1 W. W.M.

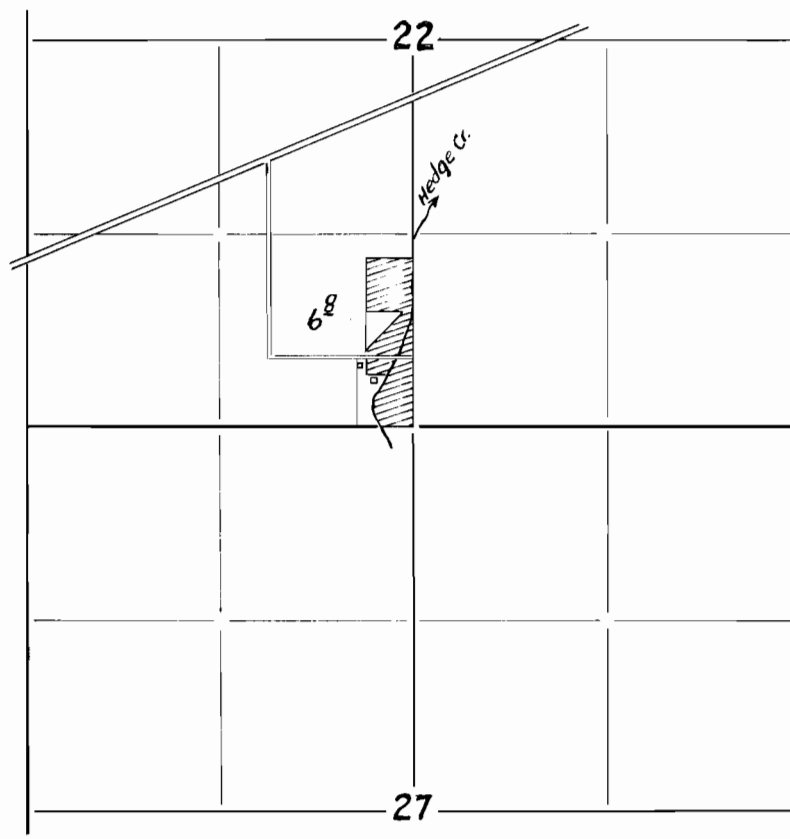

FINAL PROOF SURVEY
UNDER

Application No. 28383 Permit No. 22393
IN NAME OF

HERMAN J. & GERTRUDE W. ASCHWANDEN

Surveyed 5 - 10 1956, by M. BISH