


T. 2 S., R. 3 W., W.M.

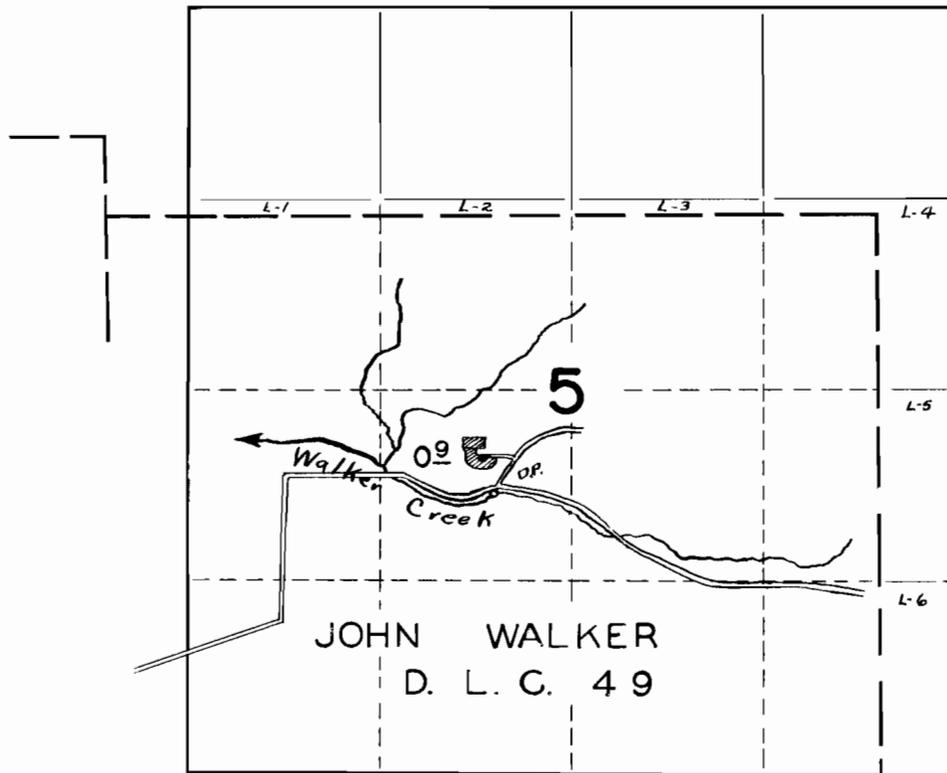

FINAL PROOF SURVEY

UNDER

Application No. 28708 Permit No. 22602
IN NAME OF

..... H. A. PECKHAM

Surveyed 9-9 1957, by W. CARR.....