


T. 2 S., R. 2 W., W.M.

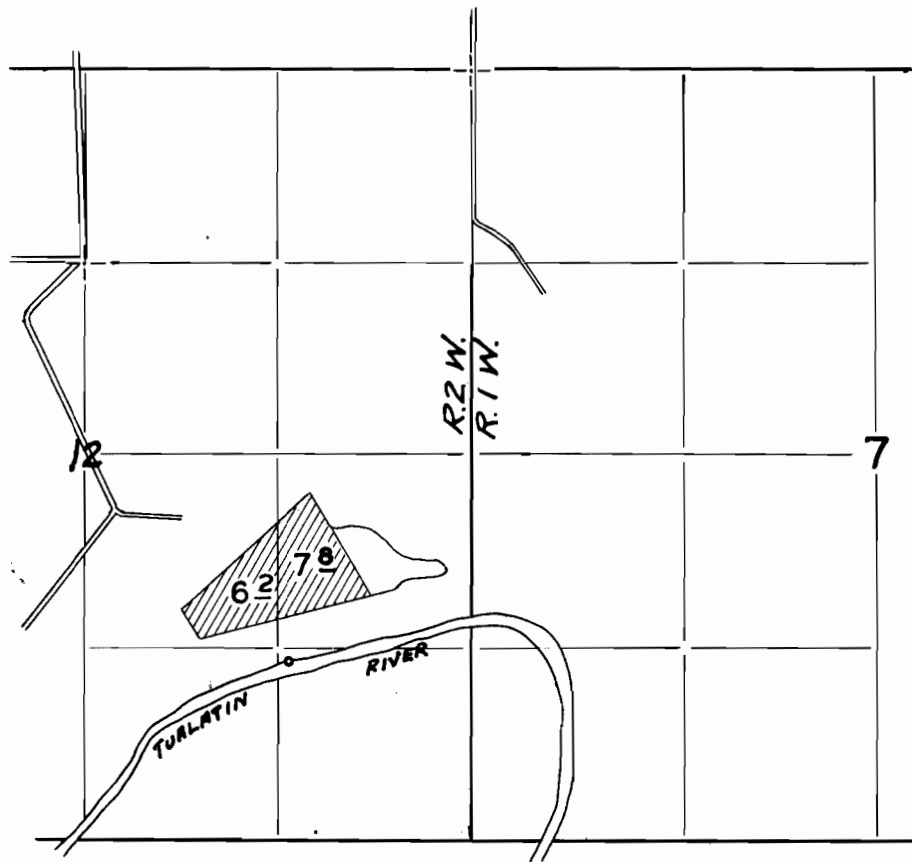

FINAL PROOF SURVEY

UNDER

Application No. 28883 Permit No. 22711
IN NAME OF

E. V. & MRS. A. M. SNIDER

Surveyed 5 - 3 1956, by M. BISH