


T. 3 N. R. 2 W. W.M.

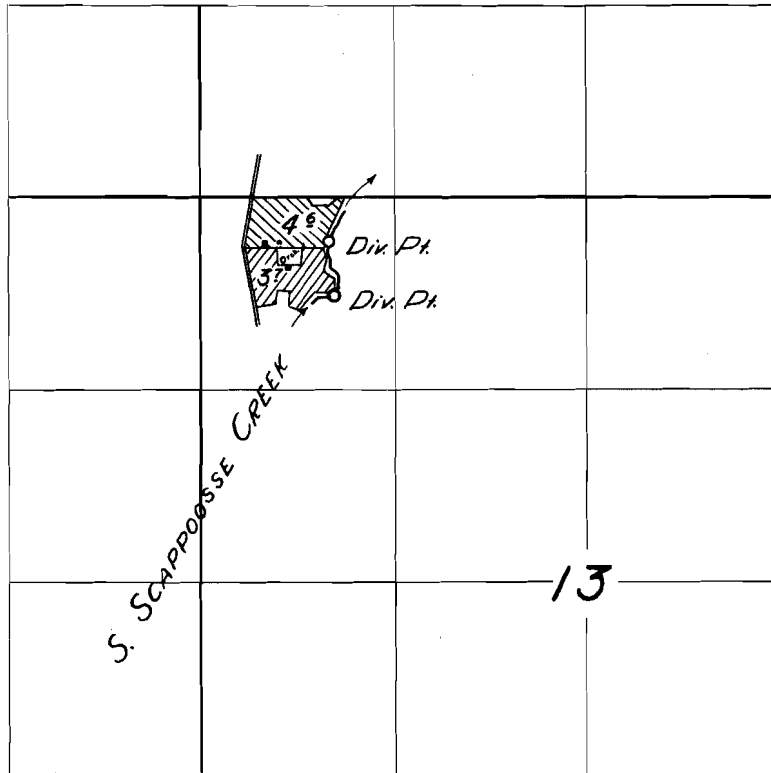

FINAL PROOF SURVEY

UNDER

27537

21694

Application No. 27567 Permit No. 22731



IN NAME OF

MARTIN T. TRTEK

Surveyed 17 July 1956, by *[Signature]*