
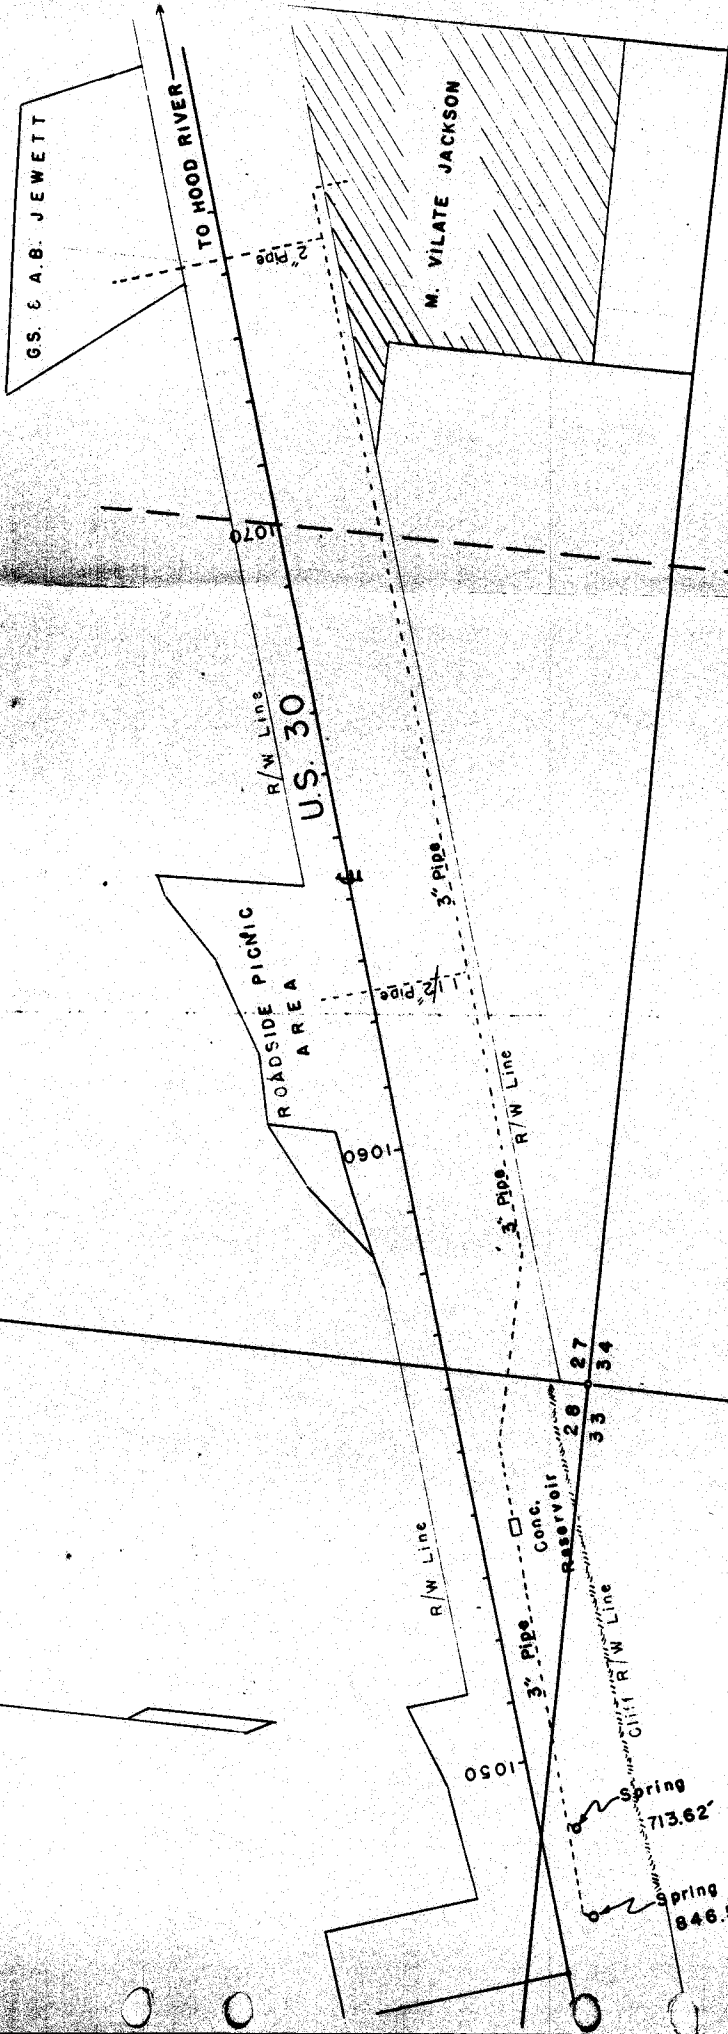


22836

T. 3 N. R. 10 E. W. M.

SCALE 1" = 200'

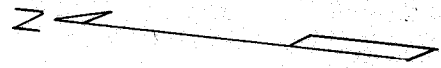

G.S. & A.B. JEWETT

TO HOOD RIVER

M. VILATE JACKSON

Application No. 29024
Permit No. 22836

Spring
713.62' W. 51.05' S. of sec. corner
Spring
846.59' W. 103.73' S. of sec. corner

REDUCED SCALE COPY ABOUT 1" = 300'