

FOLLETT & FORD

ENGINEERING & SURVEYING


S. H. FORD PHONE 5-5033

202 TIFFANY BUILDING

PHONE 4-1852

EUGENE, OREGON

R. L. FOLLETT PHONE 4-7486

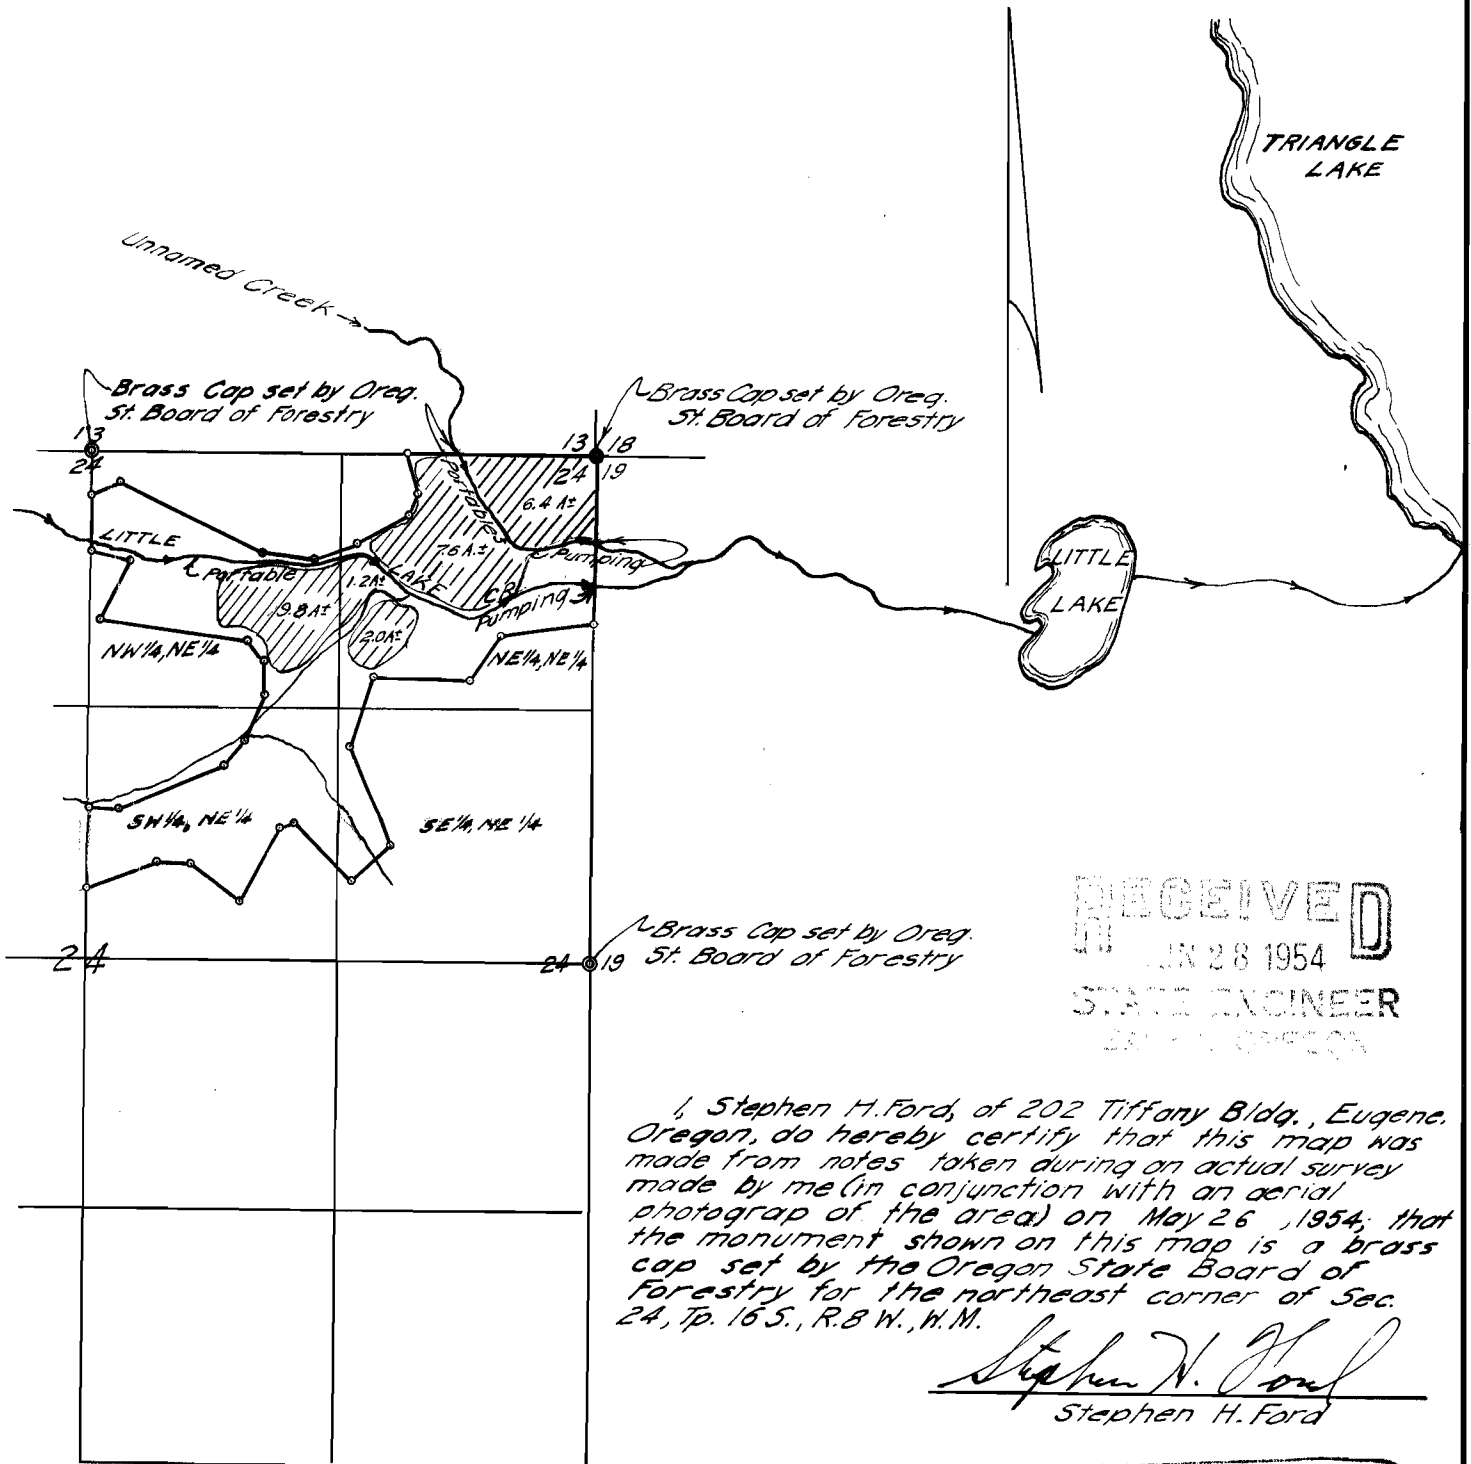

RECEIVED
JUN 28 1954
STATE ENGINEER

I, Stephen H. Ford, of 202 Tiffany Bldg., Eugene, Oregon, do hereby certify that this map was made from notes taken during an actual survey made by me (in conjunction with an aerial photograph of the area) on May 26, 1954; that the monument shown on this map is a brass cap set by the Oregon State Board of Forestry for the northeast corner of Sec. 24, Tp. 16 S., R. 8 W., W. M.

Stephen H. Ford
Stephen H. Ford

MAP OF COSTOS PROPERTY
S. 24, T. 16 S., R. 8 W., W. M.

JUNE, 1954

SCALE 1"=1000'

Application No. 29293
Permit No. 23080

