


T. 3 N. R. 2 W. W. M.

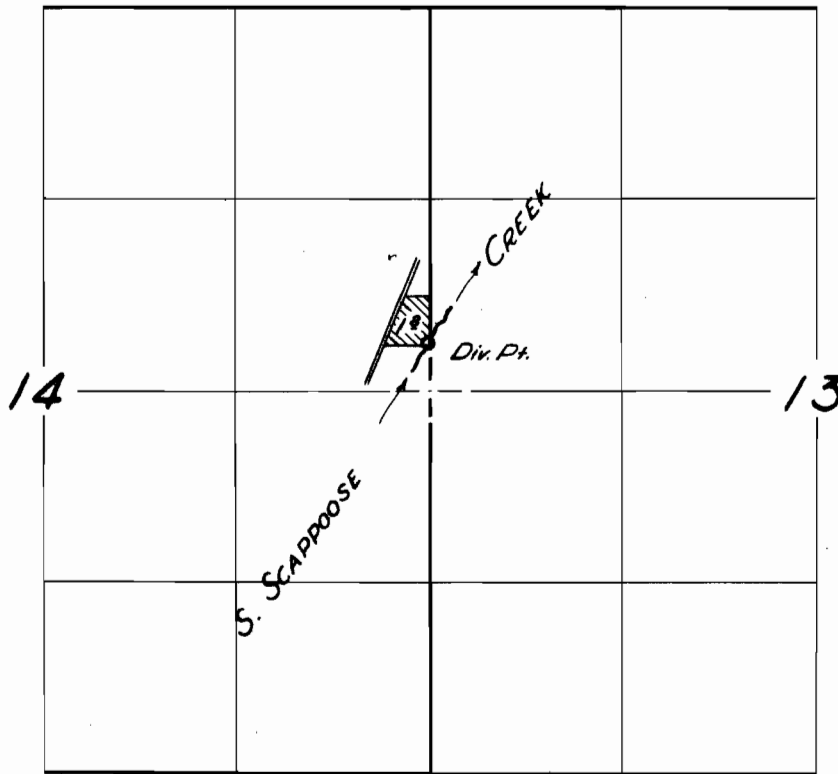

**FINAL PROOF SURVEY**  
UNDER

Application No. 29547 Permit No. 23280

IN NAME OF

CHARLES S. VAN CLEAVE

Surveyed 17 July 1956, by *Richard P. [Signature]*