


Sandy River

Spring
Conc. Res. 6'x9'
House
556'
2475'
W.C. Mon. Set in CONC.
229.16 E. of Sec. Cor.
MKD. 25/30
36/31

Spring.... Gravity Flow
0.01 Sec. Ft. Required for domestic
purposes and garden irrigation.
Spring 172' above elev. at House
No overflow. Spring appears to
drop back into crevices of
Rock Bluff.

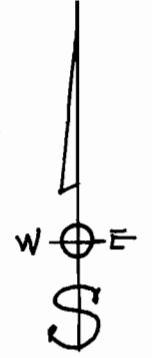

Scale 1" = 660'