


Per 24003
23733

T. 13 S. R. 28 E. W. W.

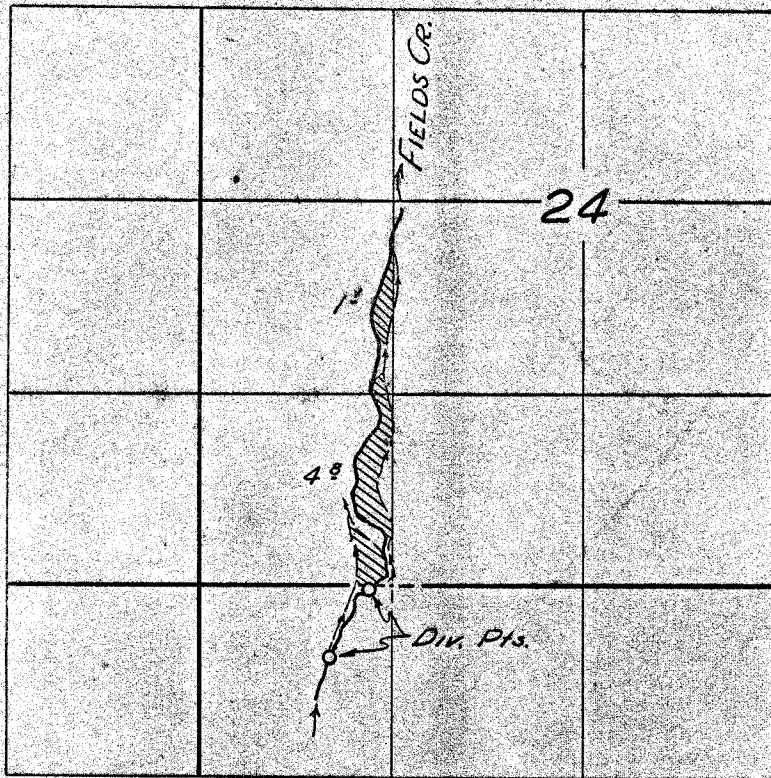

FINAL PROOF SURVEY
UNDER

Application No. 30474 Permit No. 24003
IN NAME OF

GEORGE BARRY

Surveyed 27 Oct 1956, by *[Signature]*