


T.2N. R.10W.W.M.

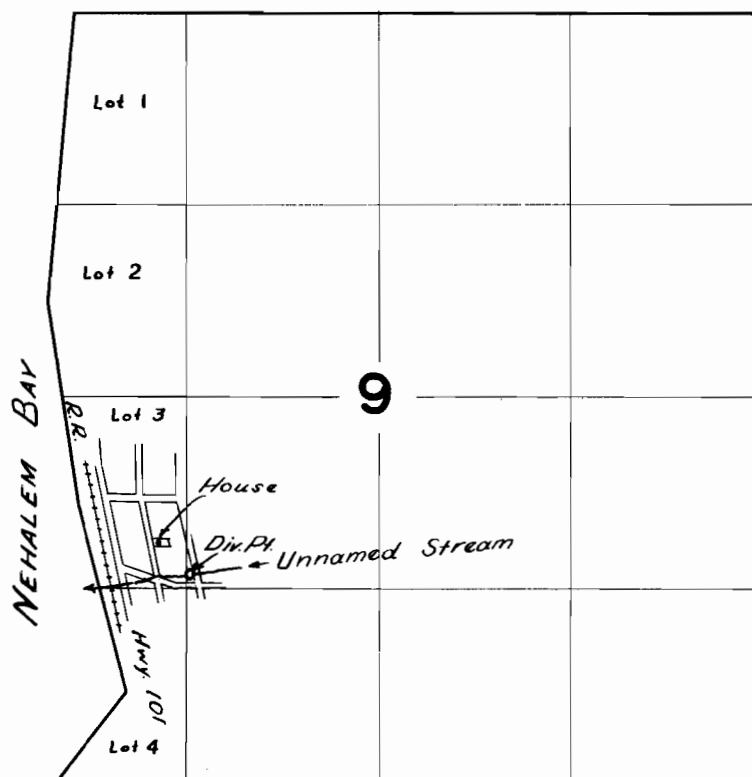

FINAL PROOF SURVEY

UNDER

Application No. 21200 Permit No. 16617

IN NAME OF

ROBERT L. & CARLEEN L. DALLAS

Surveyed 11 Aug. 1957, by Adams