


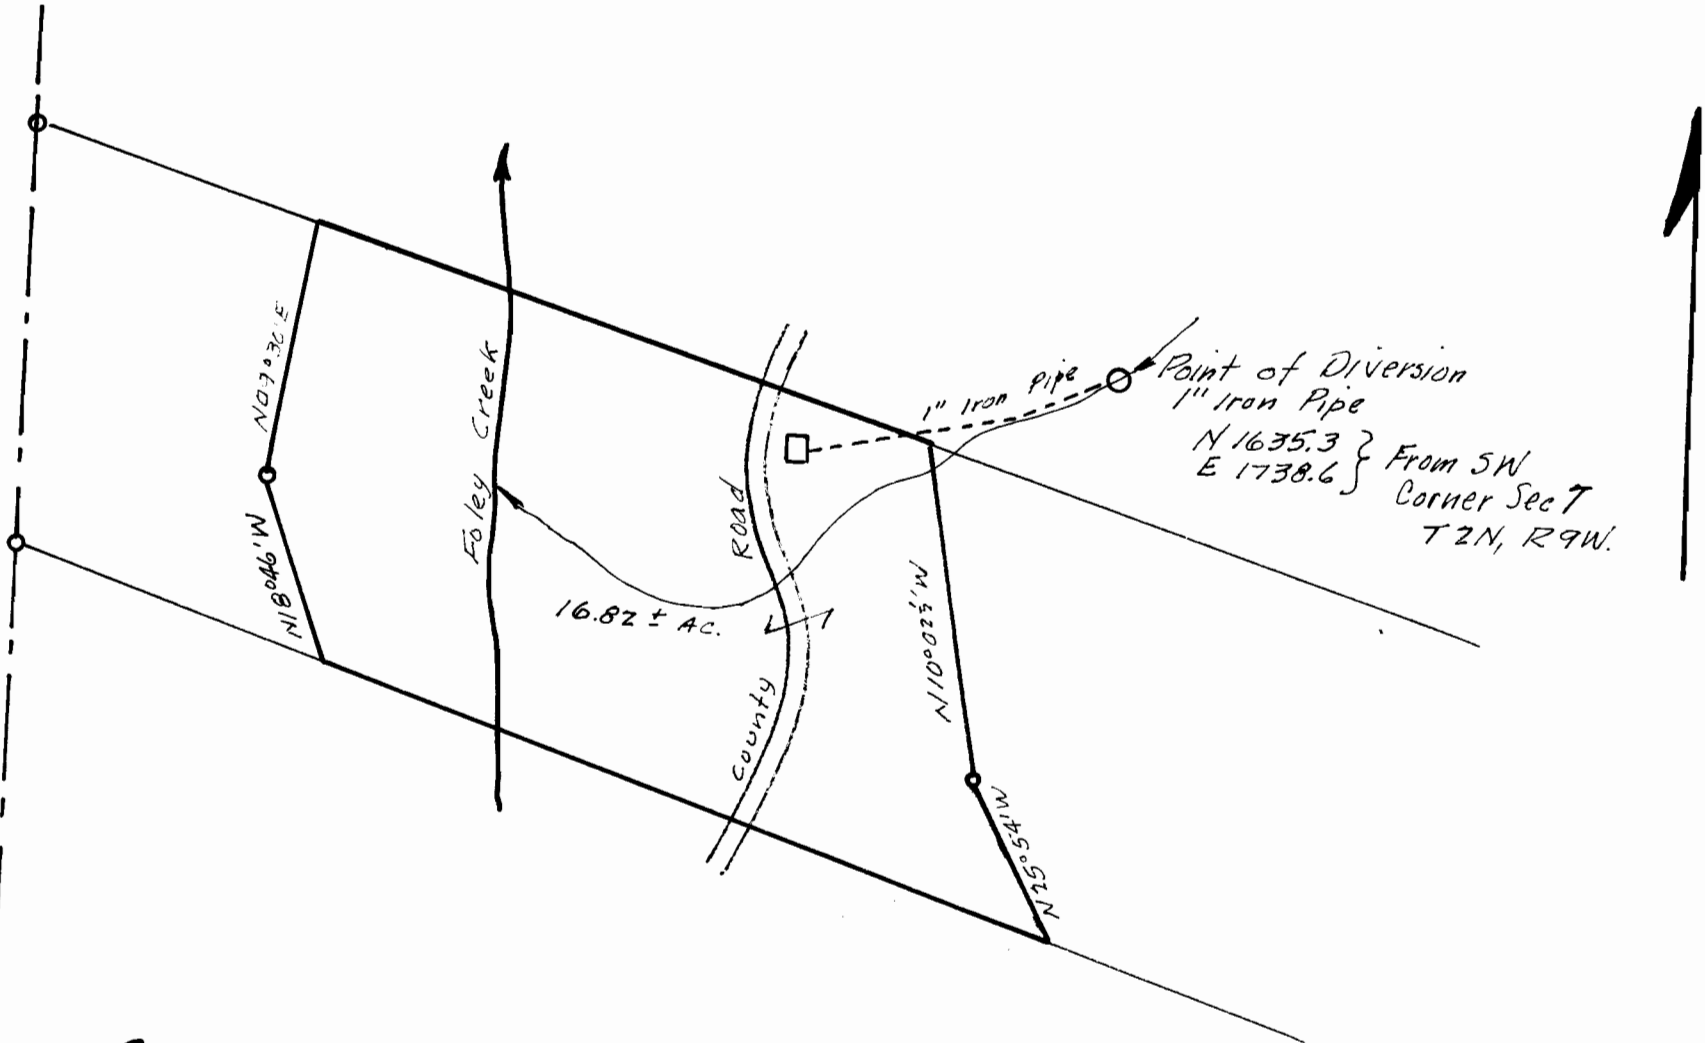

ARTHUR J. & NORA D. ERIKSON
WATER RIGHT SEC 7, T2N, R9W
SCALE 1" = 300'

I, W. A. Markham, of Arch Cape, Ore. do hereby certify that this map was made from notes of an actual survey made by me on Jan. 5, 1937.
W. A. Markham



Application No. 31391
Permit No. 24833