


T. 14 S. R. 15 E. W.M.

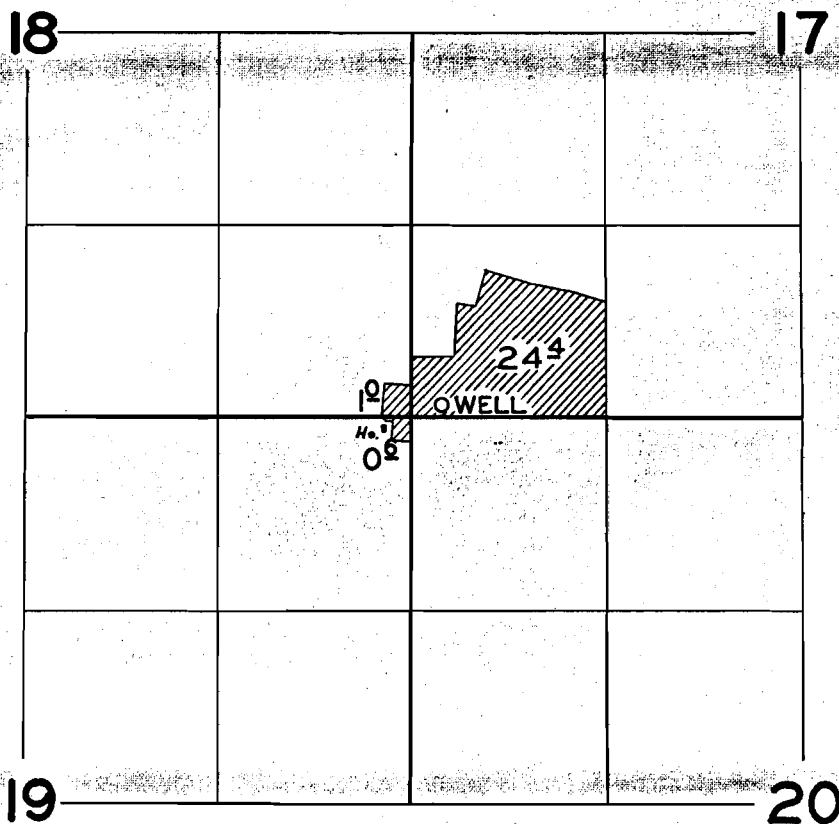

FINAL PROOF SURVEY

UNDER

Application No. U-612 Permit No. U-569

IN NAME OF

BURNS & ALICE MONTGOMERY

Surveyed AUG. 1, 1957, by C.O. BARTELS

U-569
1957W

2-569