


T.10S.R.1E.W.M.

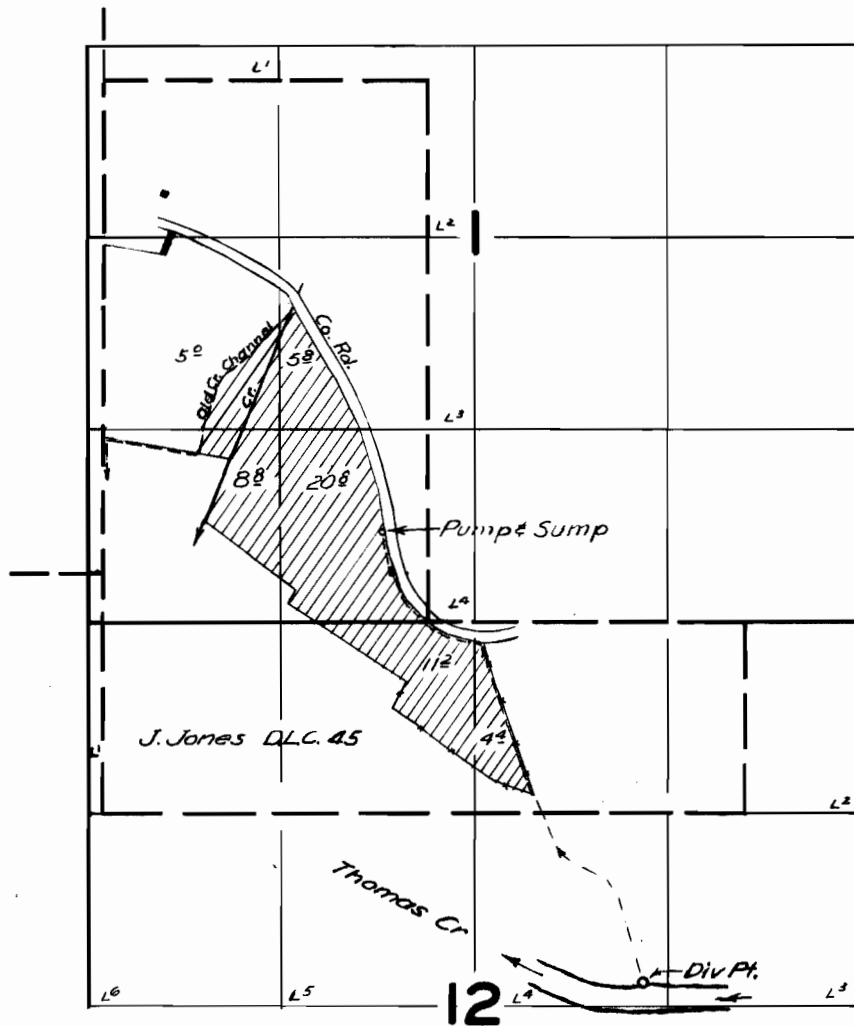

FINAL PROOF SURVEY UNDER

Application No. 14805 Permit No. 11585
IN NAME OF

Fred Rohwein

Surveyed April 14 1957, by Tom Bish