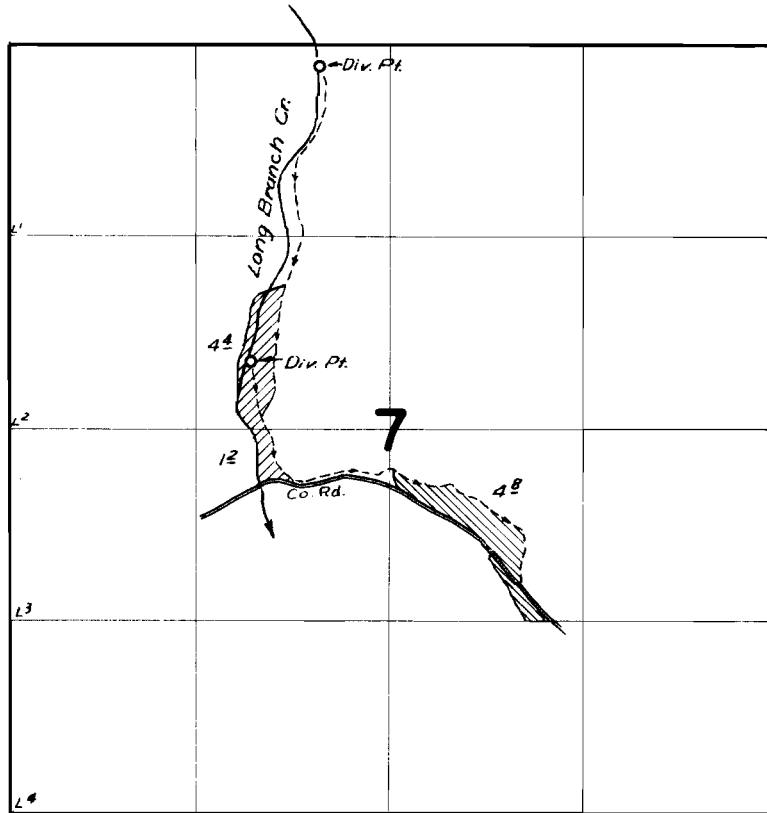

 


T. 8 S. R. 47 E. W.M.



FINAL PROOF SURVEY

UNDER

Application No. 17346 Permit No. 13141 
~~24321~~ 19065 

IN NAME OF

.....J. J. Hendrix.....

Surveyed Oct. 18, 1956, by Tr. Bish.....