


T.16S.R.5W.W.M.

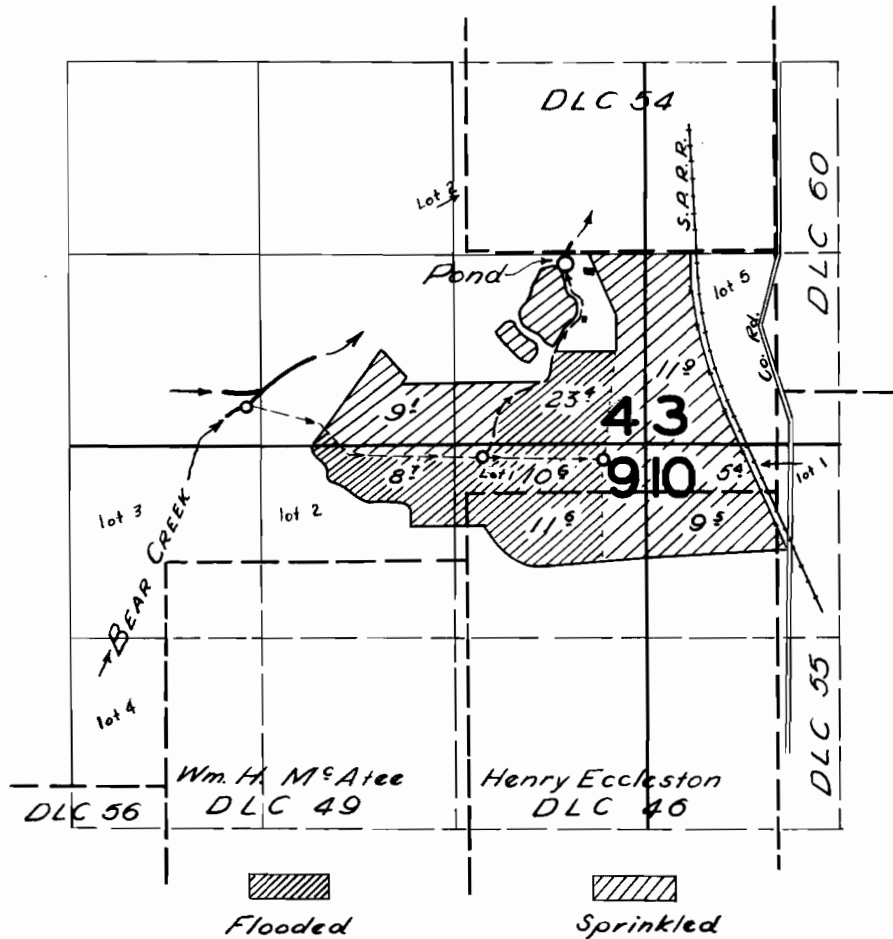

FINAL PROOF SURVEY
UNDER

Application No. 19813 Permit No. 15415

IN NAME OF

J. M. Mc Cormick

Surveyed 10 April 1957, by *R. W. Bibby*