


T.I.S.R.3 W.W.M.

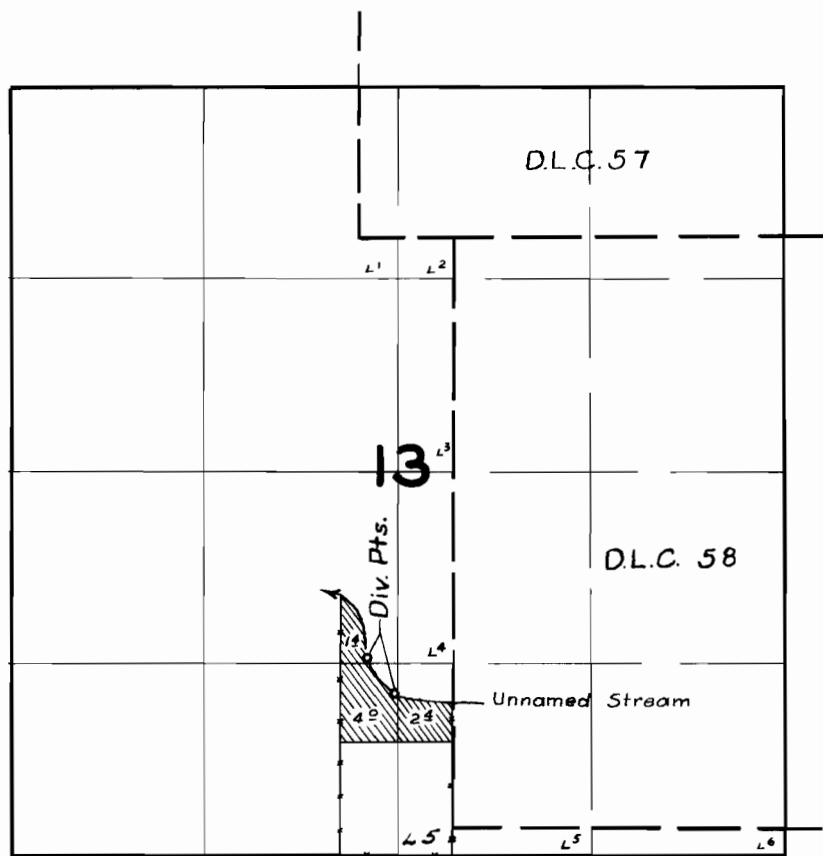

FINAL PROOF SURVEY

UNDER

Application No. 22929 Permit No. 18074

IN NAME OF

Severt Melheim

Surveyed Mar. 22 1957, by Tom Bish