


# T.17 S.R.1 W.W.M.

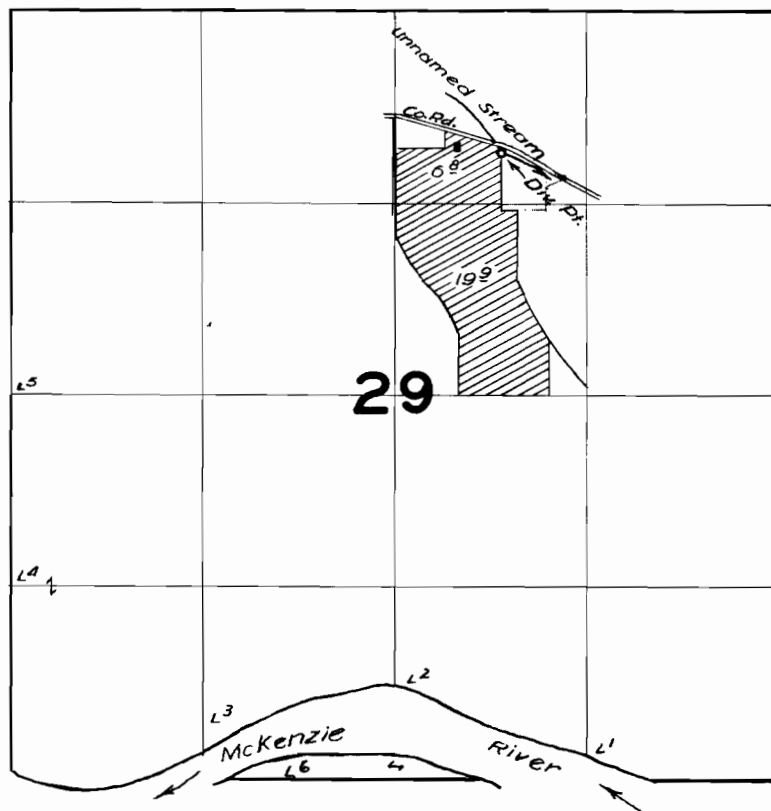

## FINAL PROOF SURVEY

UNDER

Application No. 24431... Permit No. 19246...

IN NAME OF

*Glen Vaughan & Dara Vaughan*

Surveyed *May 16, 1957*, by *M. Bick*