


T.I.O S.R.I E.W.M.

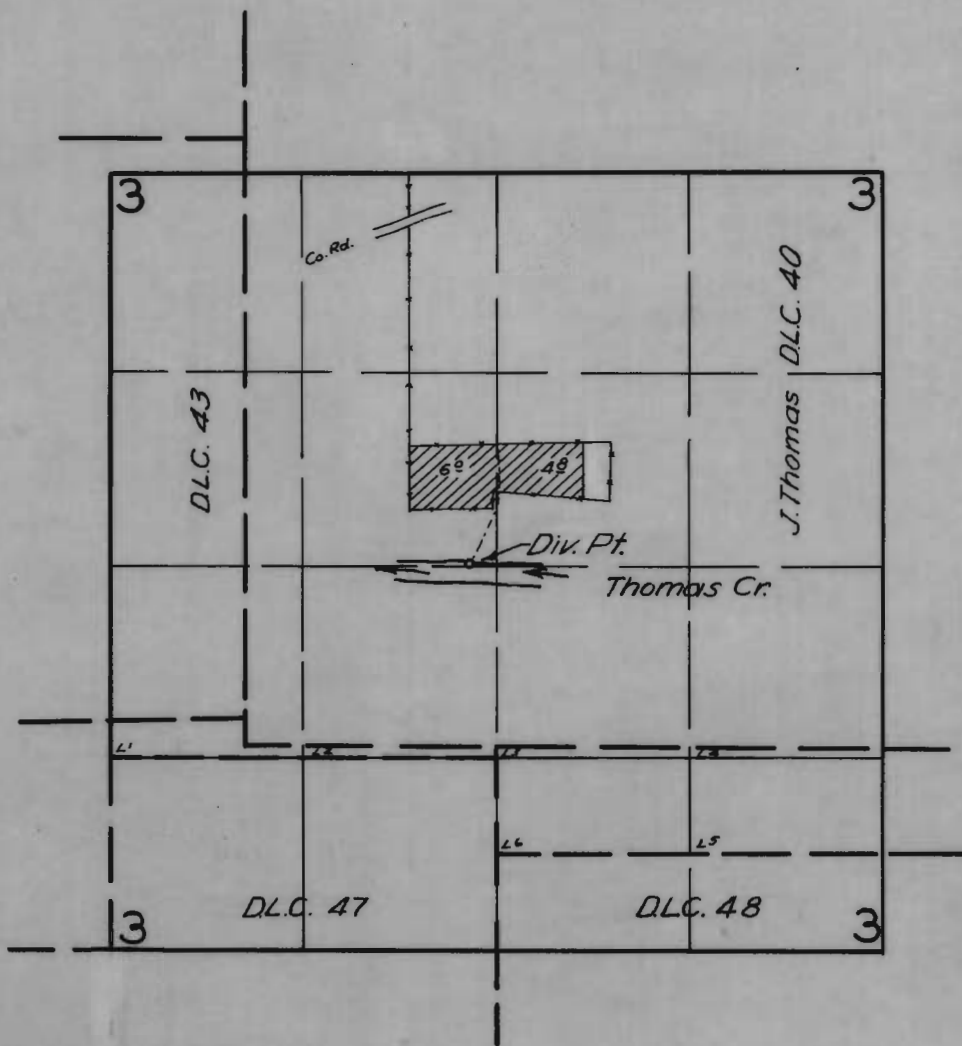

FINAL PROOF SURVEY

UNDER

Application No. 24833 Permit No. 19674

IN NAME OF

Grace Weeder

Surveyed April 2, 1957, by M. Bish

1957-B