


T.10 S.R.1 E.W.M.

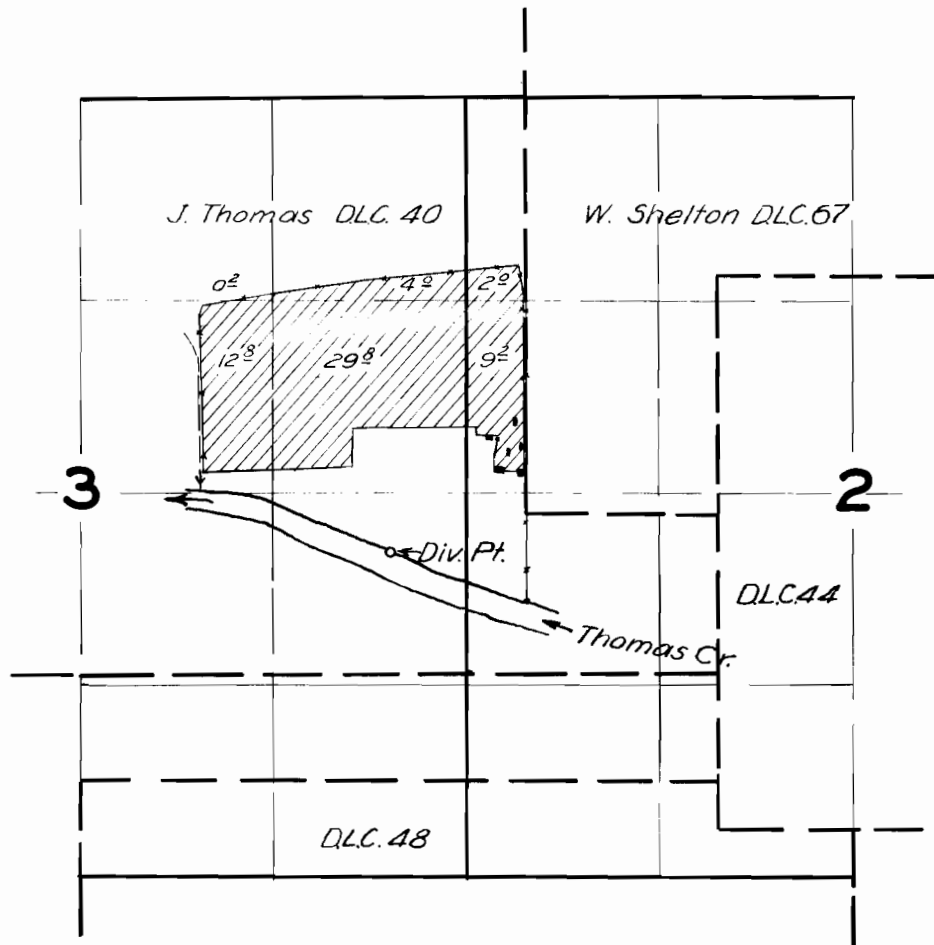

FINAL PROOF SURVEY UNDER

Application No. 26574 Permit No. 21009
IN NAME OF

John Silbernagel

Surveyed April 3, 1957, by *M. Bish*