


T. 16S. R. 6 W. W.M.

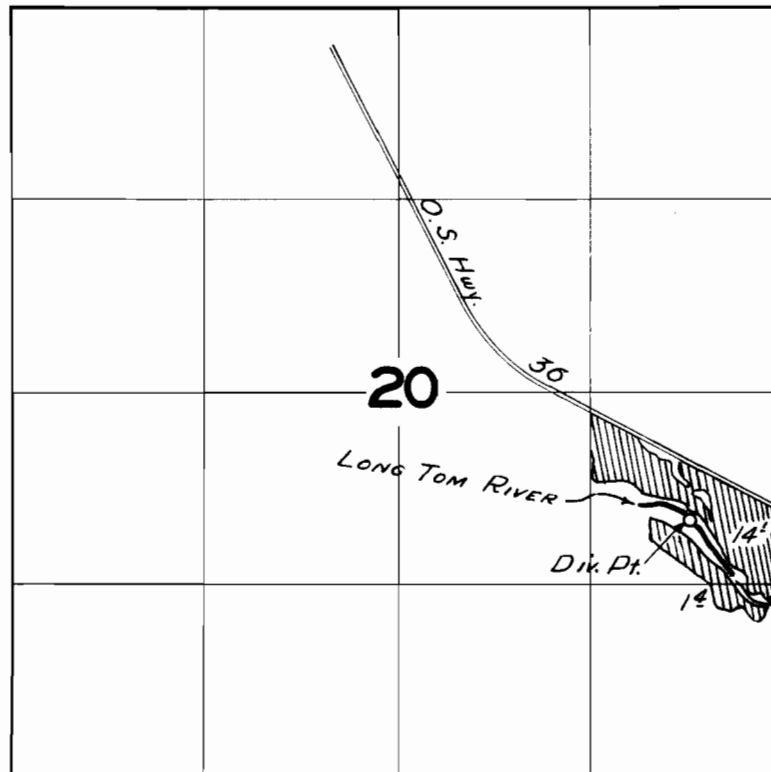

FINAL PROOF SURVEY
UNDER

Application No. 26767 Permit No. 21033
IN NAME OF

LOREN E. WATSON

Surveyed 11 April 1957, by *Chas. H. H. H. H.*

DBQ-8H-163