


T. 1S. R. 9W. W.M.

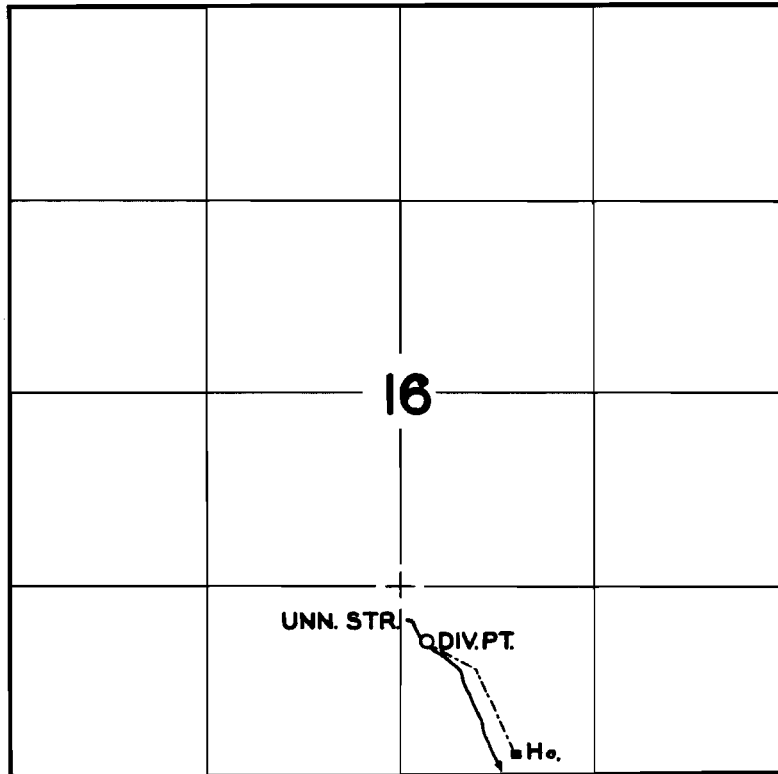

FINAL PROOF SURVEY

UNDER

Application No. 26825. Permit No. 21067.
IN NAME OF

WILLIAM BORGELT

Surveyed AUG. 26 1957, by C.O. BARTELS