


T.12 S.R.I.W.W.M.

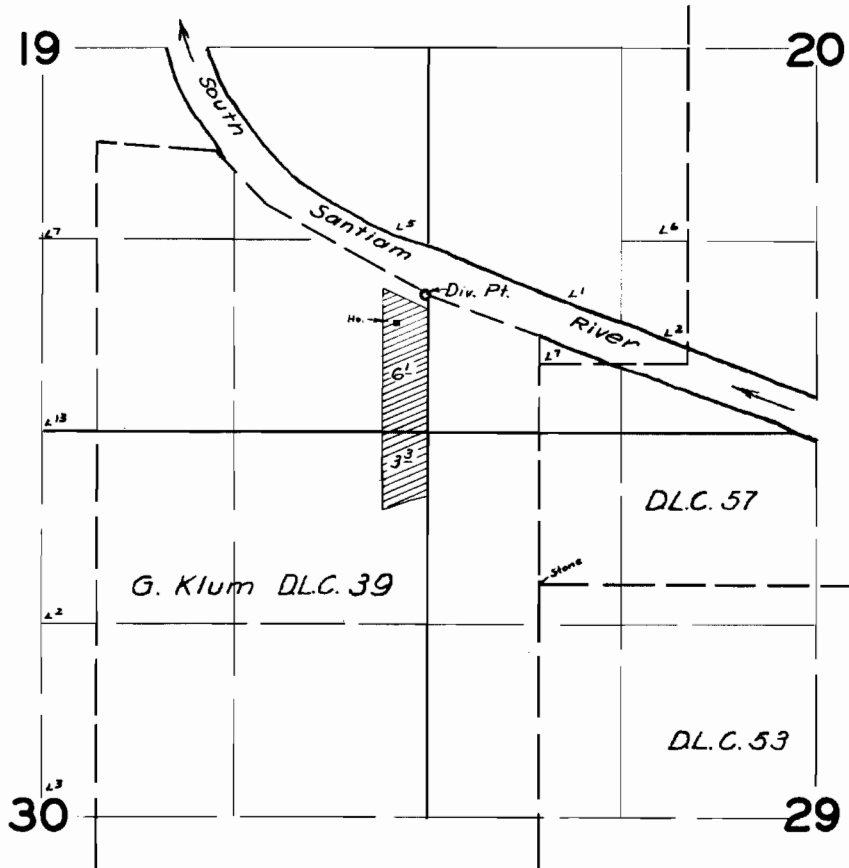

FINAL PROOF SURVEY UNDER

Application No. 26876... Perm't No. 211102...
IN NAME OF

Carl Martin

Surveyed *July 12, 1957*, by *m. Bish*