


T. 30S. R. 3W. W.M.

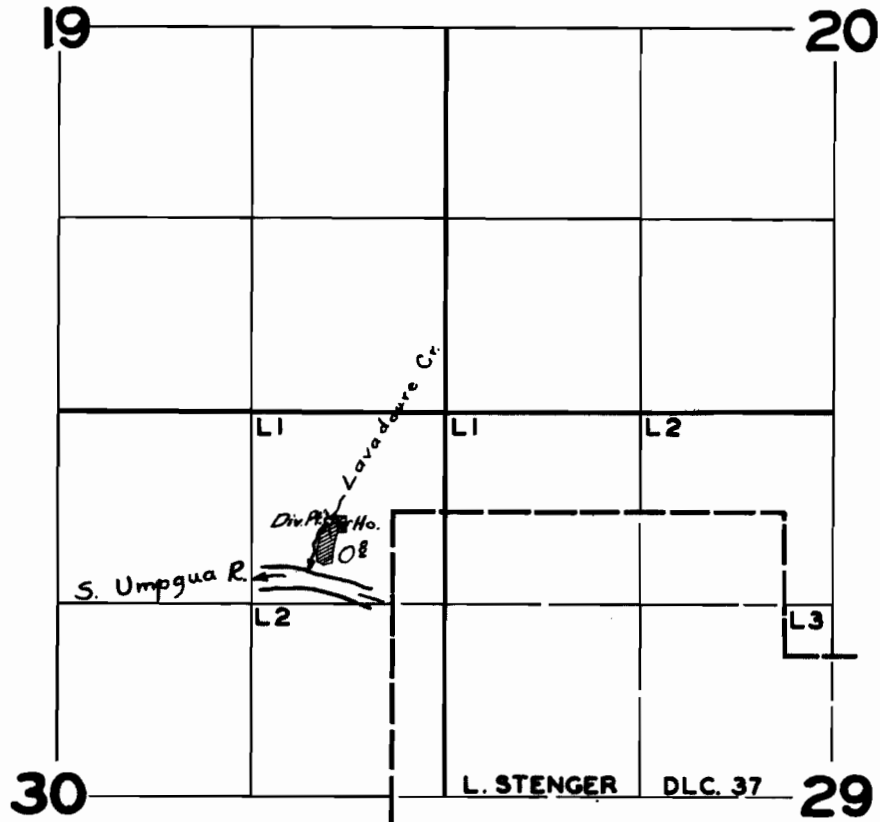

FINAL PROOF SURVEY

UNDER

Application No. 27060 Permit No. 21291

IN NAME OF

IVAN & MAE WELCH

Surveyed JUNE 22 1957, by C. O. Daniels