


T.16S.R.6W.W.M.

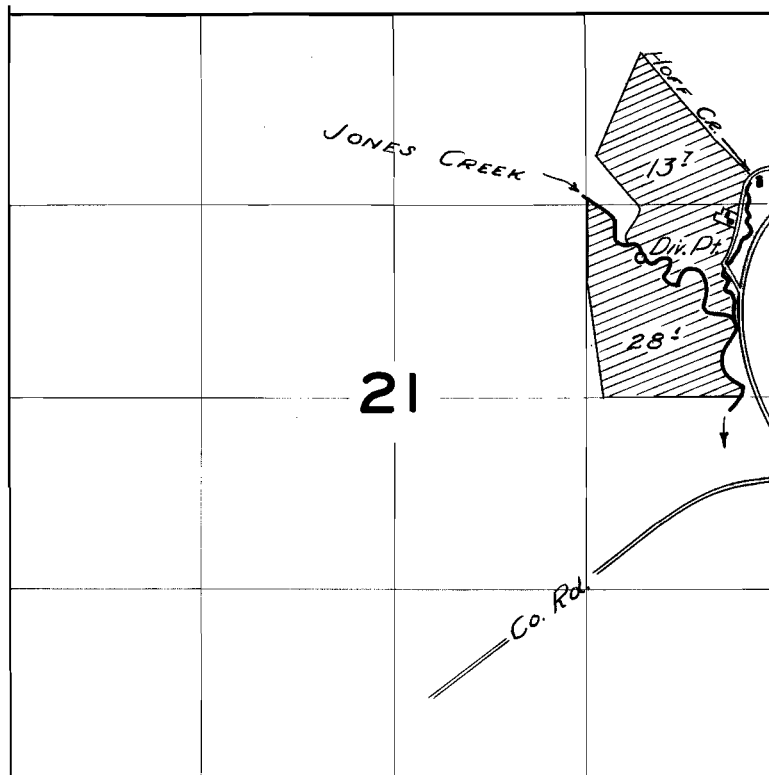

FINAL PROOF SURVEY
UNDER

Application No. 27491 Permit No. 21638
IN NAME OF

JACK LIMHOUSE

Surveyed 11 April 1957, by R. W. Little