


T.I.O.S.R.I.E.W.M.

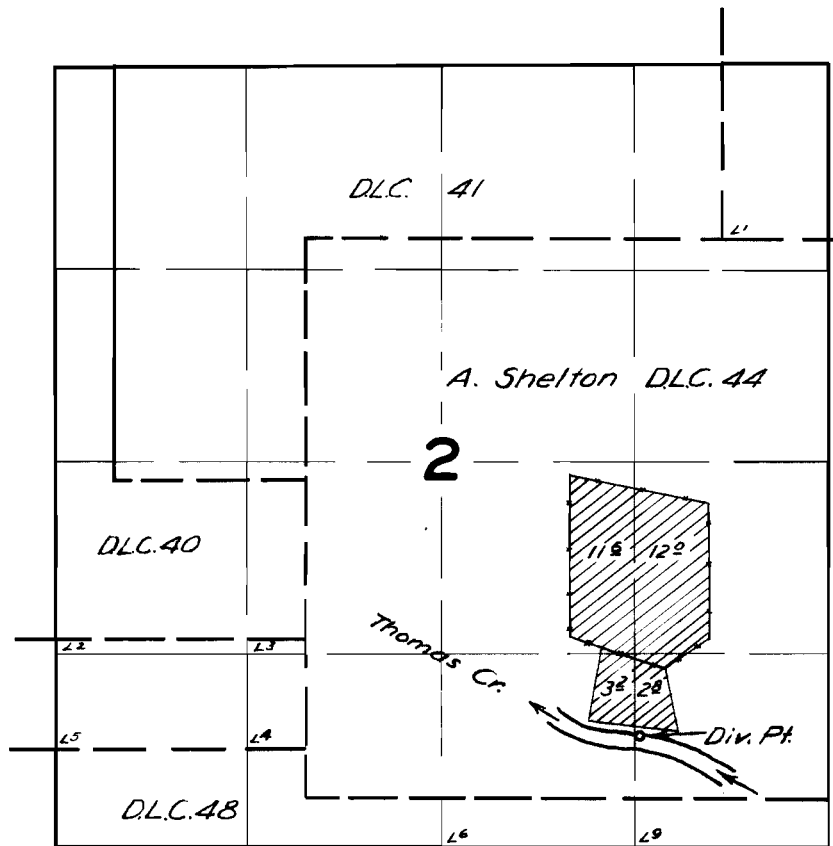

FINAL PROOF SURVEY

UNDER

Application No. 27950 Permit No. 22008

IN NAME OF

John A. Rohwein

Surveyed April 5, 1957, by *M. Bish*