


T. 32S. R. 6W. W.M.

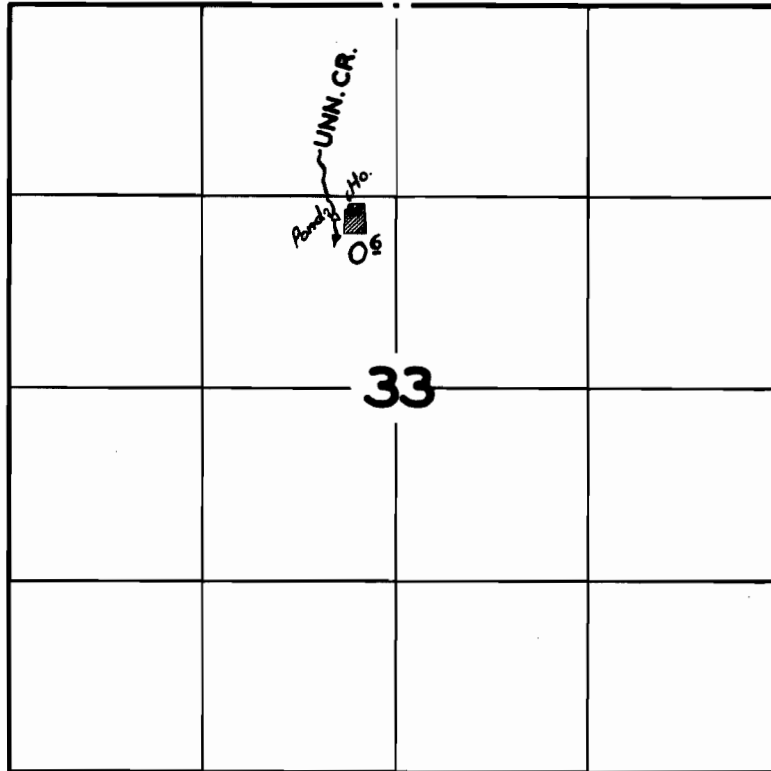

FINAL PROOF SURVEY
UNDER

Application No. 28049 Permit No. 22064
IN NAME OF

THE ROBERT DOLLAR COMPANY

Surveyed JUNE 18, 1957, by C. O. Burtch