
T. 30S. R. 3W. W.M.

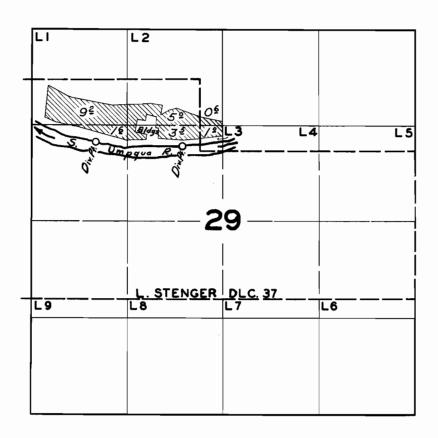

FINAL PROOF SURVEY

UNDER

Application No. 28160 Permit No. 22161 IN NAME OF

ROY V. & EDITH A. MATTHEWS

Surveyed JUNE 22 19.57, by C.O.Barlet