


T.I 8 S.R.I W.W.M.

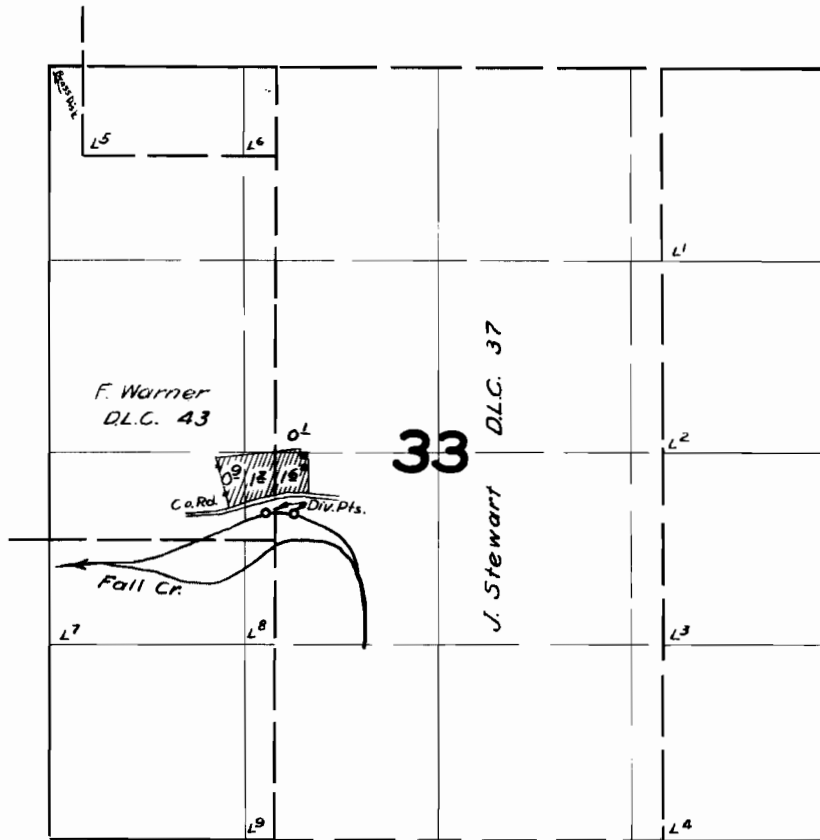

FINAL PROOF SURVEY

UNDER

Application No. 28262 Permit No. 22223
IN NAME OF _____

Pawlo & Maria Myronenko

Surveyed May 3, 1957, by Tr. Bish