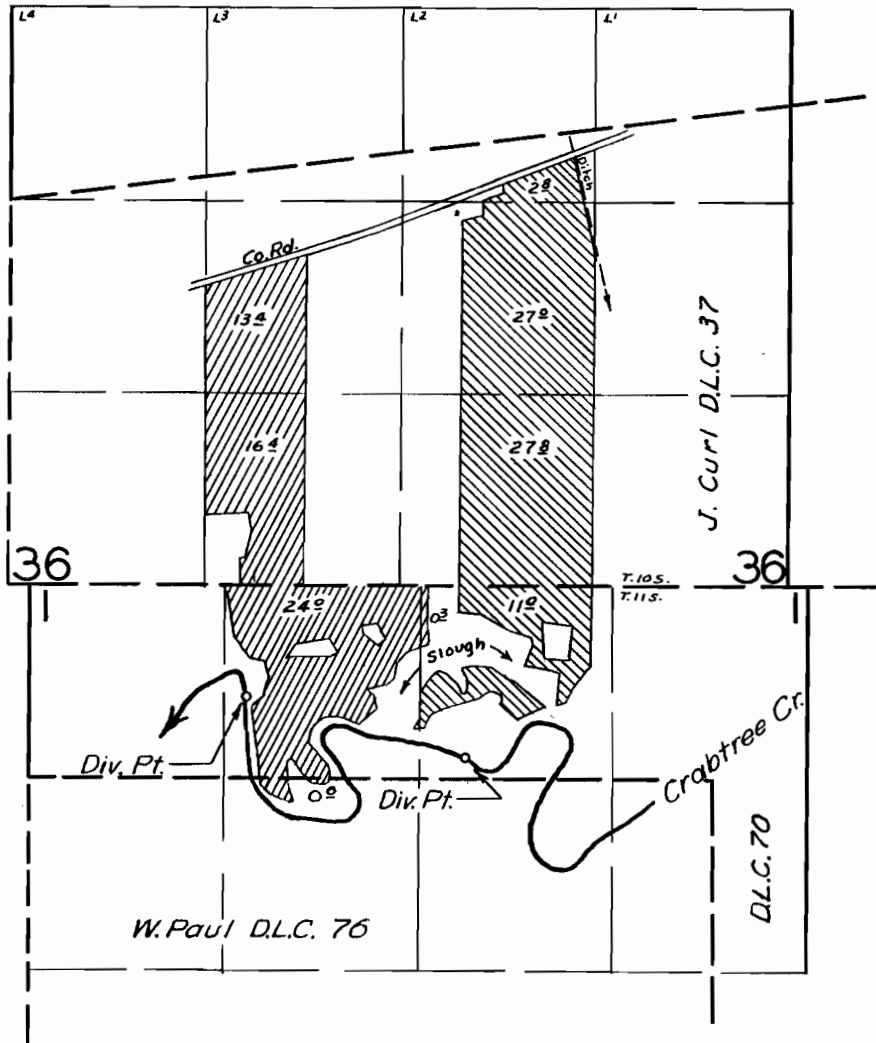

 


T.10 & 11 S.R.2 W.W.M.



FINAL PROOF SURVEY

UNDER

Application No. 28487 Permit No. 22308 
 Application No. 28466 Permit No. 22293 

IN NAME OF

E. R. Walker

Surveyed Mar. 20 1957, by M. Bishop