


T.20 S.R.4 W.W.M.

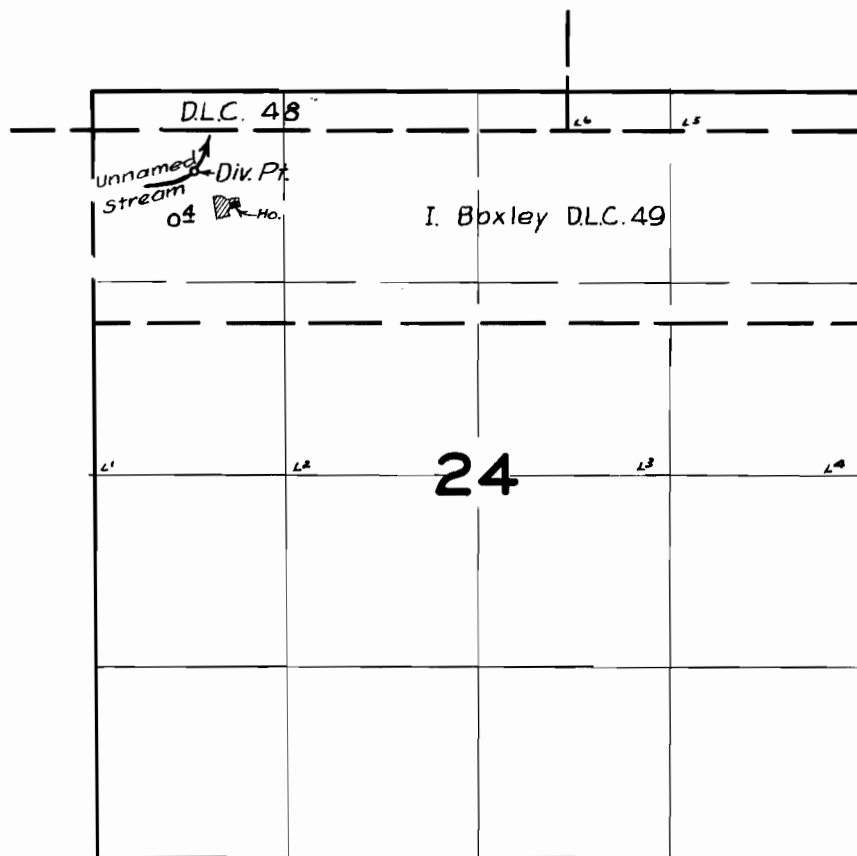

FINAL PROOF SURVEY UNDER

Application No. 28347 Permit No. 22371
IN NAME OF

Jacob J. & Fern V. Meyer

Surveyed April 17, 1957, by M. Bish