T.20 S.R.3 W.W.M.

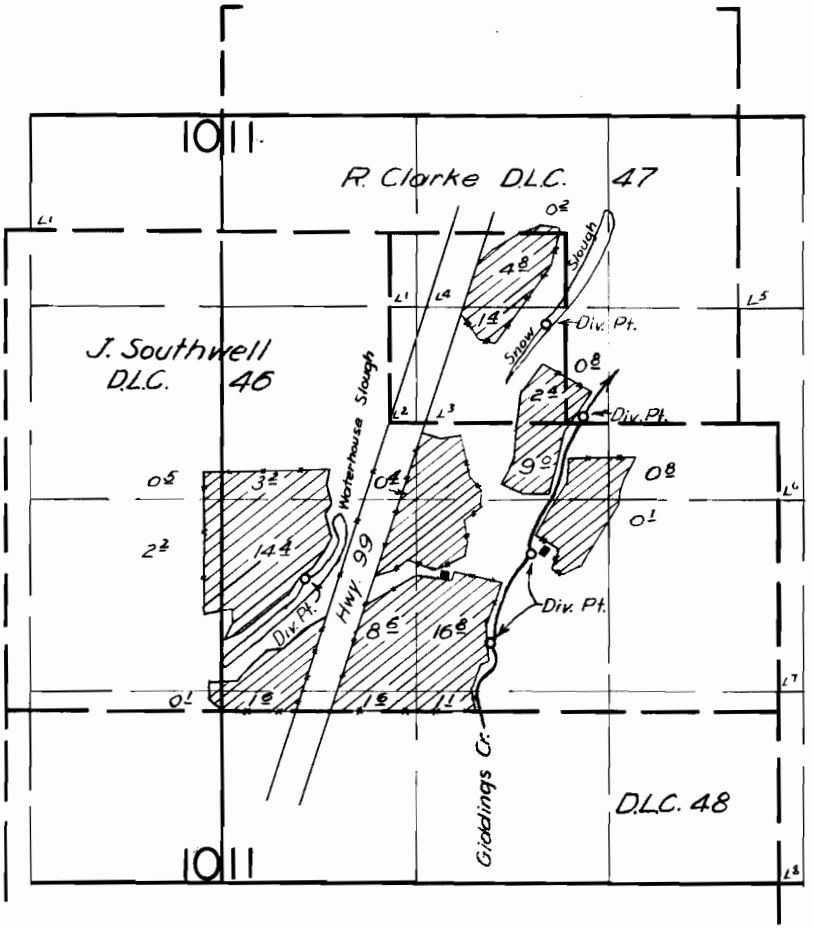

FINAL PROOF SURVEY

UNDER

Application No. 28214 Permit No. 22440

IN NAME OF

The S & A Company

Surveyed April 16 1957, by Tm. Bish

1957-B