


T.18 S.R.2 W.W.M.

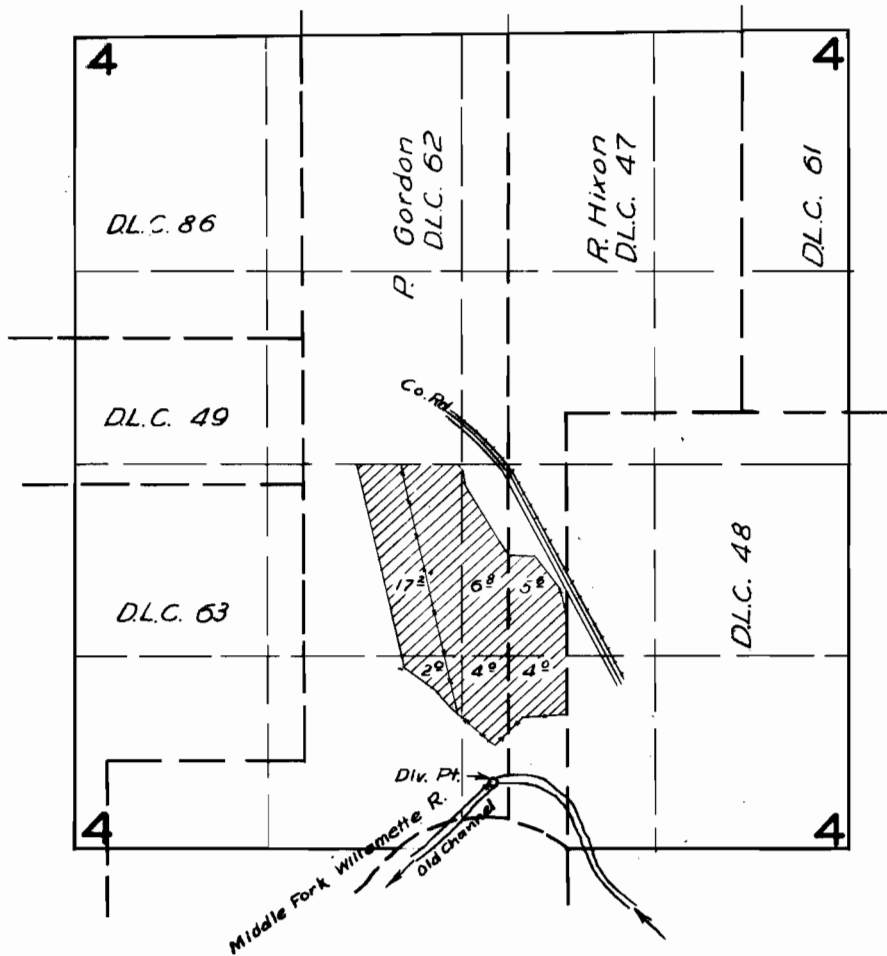

FINAL PROOF SURVEY

UNDER

Application No. 28691... Permit No. 22592...

IN NAME OF

Truman A. & Lola L. Chase - Lloyd F. & Ireta A. Whiteaker

Surveyed April 29 1957, by Tom Bish.....