


T. 30S. R. 3W. W.M.

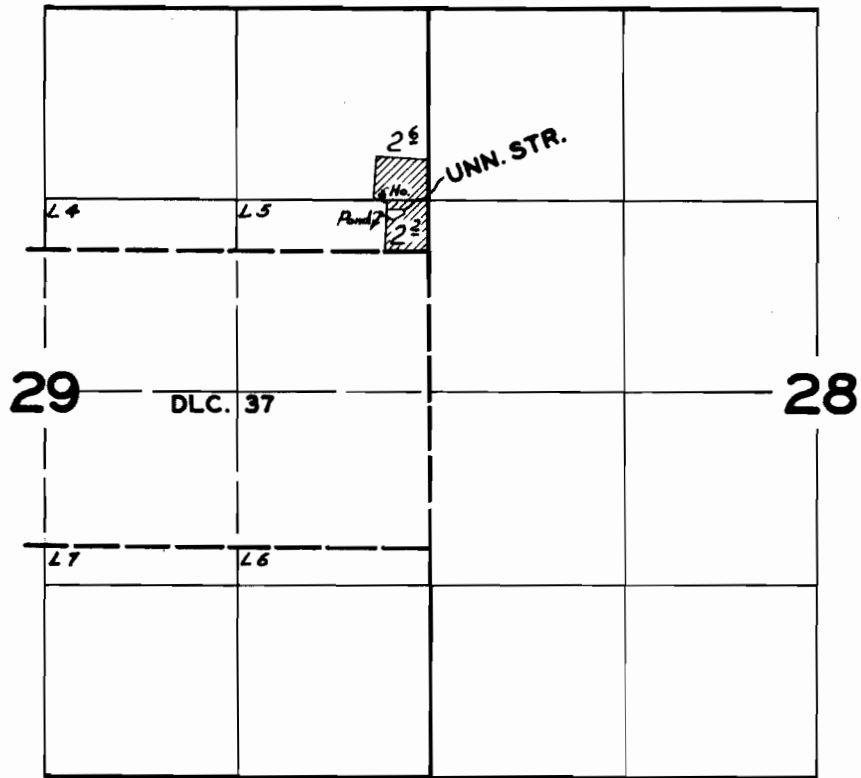

FINAL PROOF SURVEY
UNDER

Application No. 28759 Permit No. 22620
IN NAME OF

G.H. SWALLEY

Surveyed JUNE 22 1957, by C.O. Burtch