


T.18 S.R.2 W.W.M.

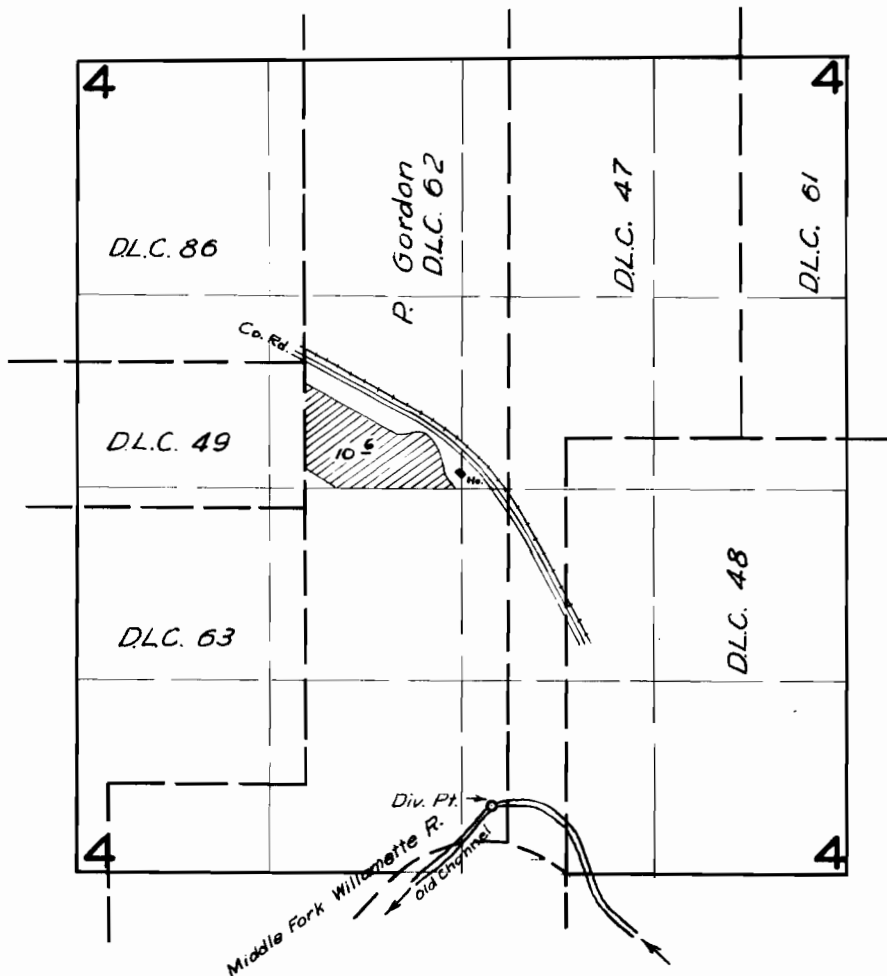

FINAL PROOF SURVEY UNDER

Application No. 28885..... Permit No. 22712.....
IN NAME OF

.....*W.W. & Marge Dow*.....

Surveyed *April 29* 1957, by *M. Rich*.....