


T. 5S. R. 3W. W.M.

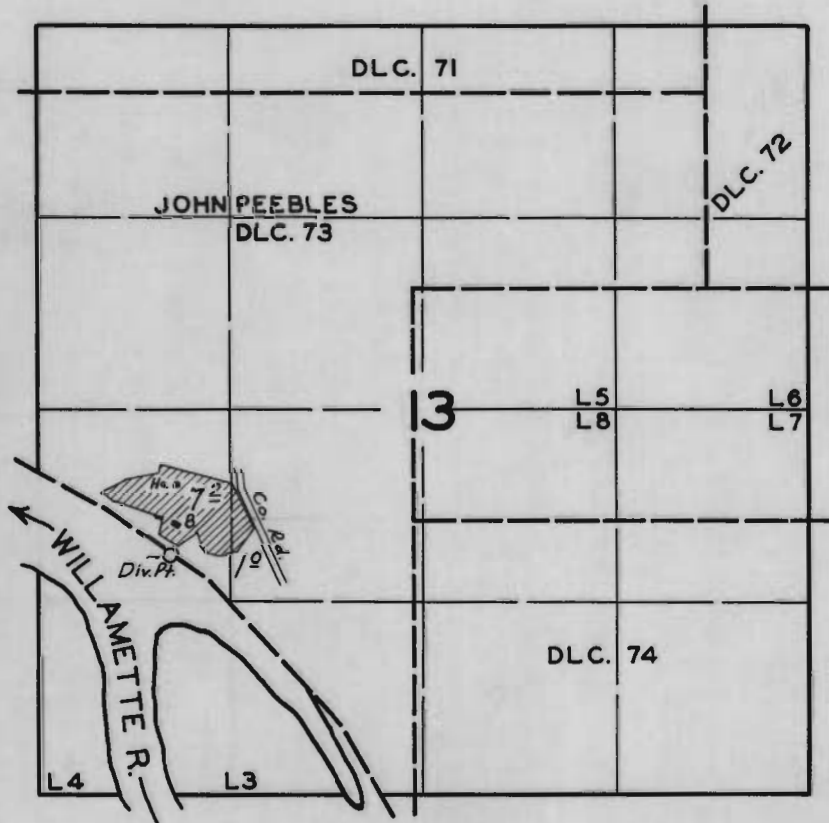

FINAL PROOF SURVEY
UNDER

Application No. ~~28988~~ Permit No. 22727
IN NAME OF

ROBERT L. PARTSCH

Surveyed MAR. 12, 1957, by *C. O. Smith*