


T17SR2WWM

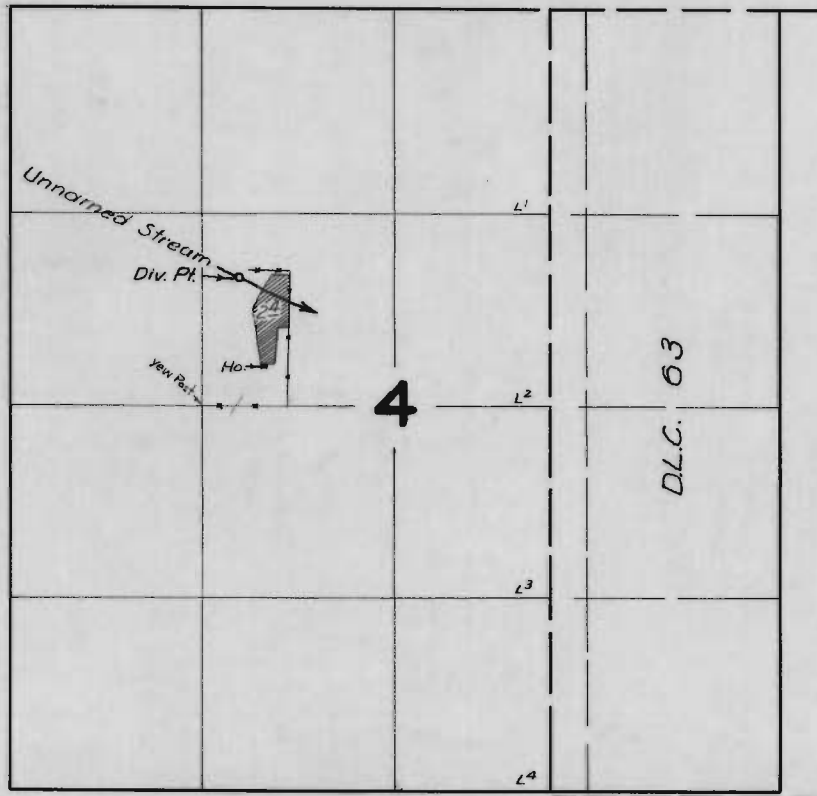

FINAL PROOF SURVEY UNDER

Application No. 29031... Permit No. 22840...
IN NAME OF

.....Horace A. & Ruth E. Taylor.....

Surveyed May 7, 1957, by Tom Bish.....