


T. 30 S. R. 4 W. W.M.

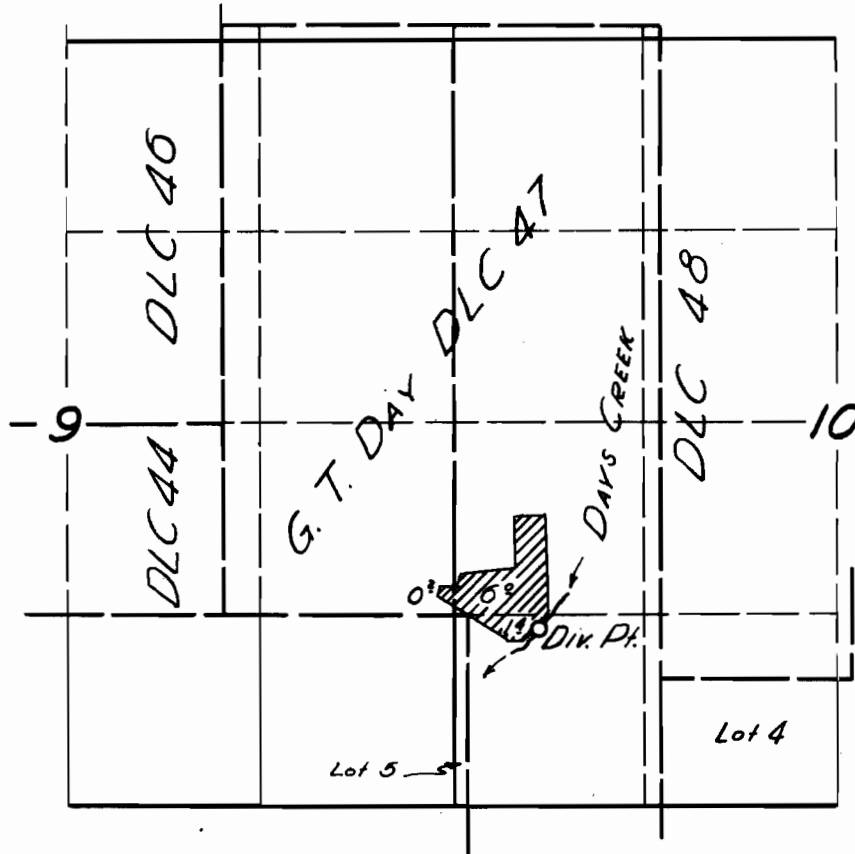

**FINAL PROOF SURVEY**

UNDER

Application No. 27989 Permit No. 22900

IN NAME OF

DURNIN SWINGLEY

Surveyed 15 Oct. 1950, by [Signature]