


T.20S.R.3W.W.M.

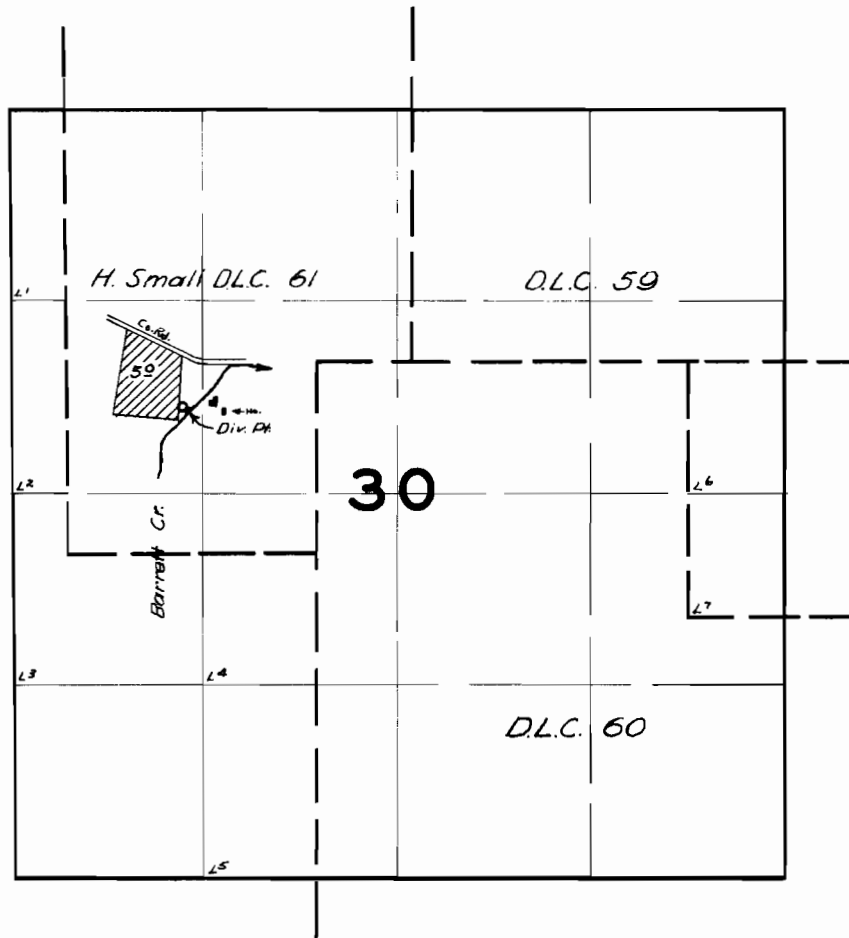

FINAL PROOF SURVEY

UNDER

Application No. 28671 Permit No. 22968

IN NAME OF

Cecil W. & Elma C. Umpleby

Surveyed April 15 1957, by M. Bish