


# T.7S.R.5W.WM

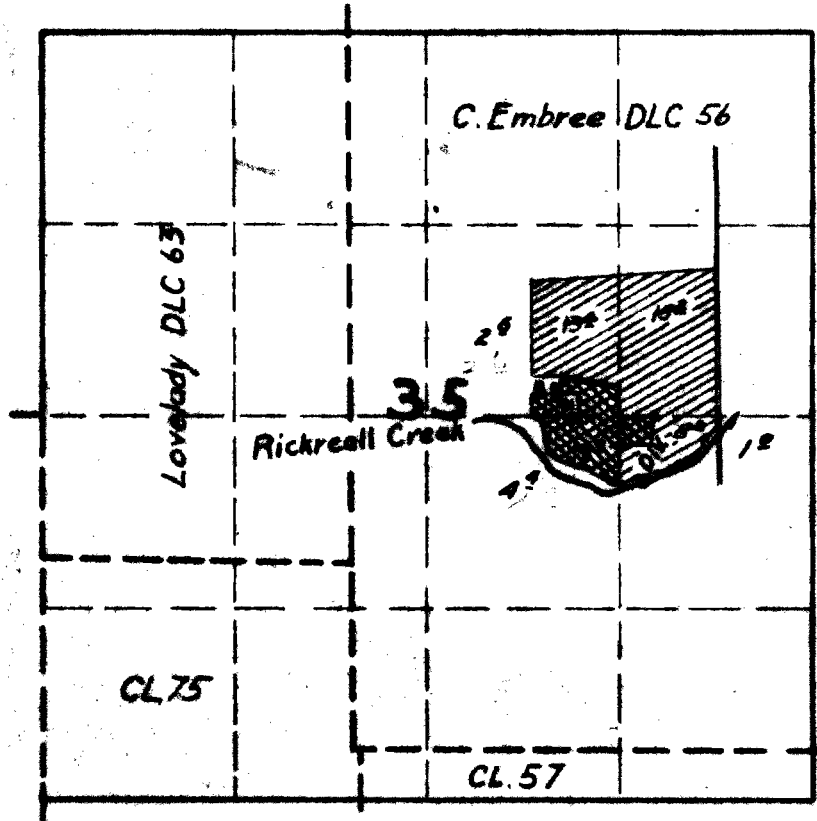

applied for this Application

## FINAL PROOF SURVEY UNDER

Application No. 23608... Permit No. 18872

IN NAME OF

Feta Brandt

**Application No. 29683**

**Permit No. 23374**

Surveyed Aug. 5, 1954, by T. Jones