


T.17 S.R.2 W.W.M.

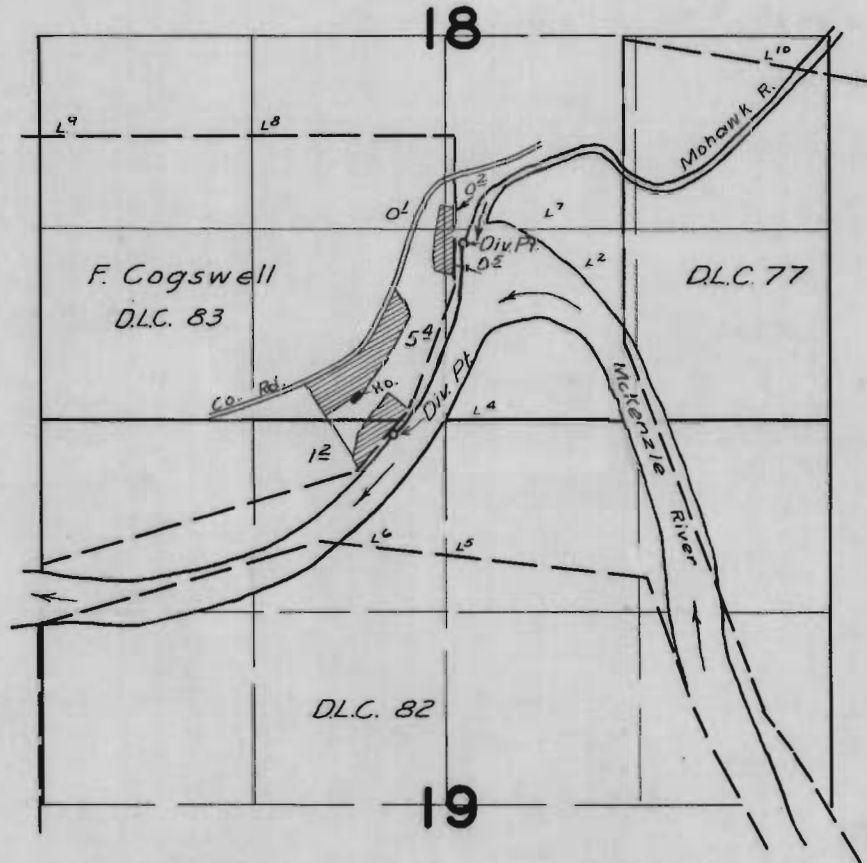

FINAL PROOF SURVEY  
UNDER

Application No. 29029 Permit No. 23481  
IN NAME OF

Arthur H. Hendershott

Surveyed May 6 1957, by M. Bish